T.22S. R.46E. W.M.
MALHEUR COUNTY

1" = 2000

WORK COPY

RECEIVED
SEP 22 2006
WATER RESOURCES DEPT
SALEM, OREGON
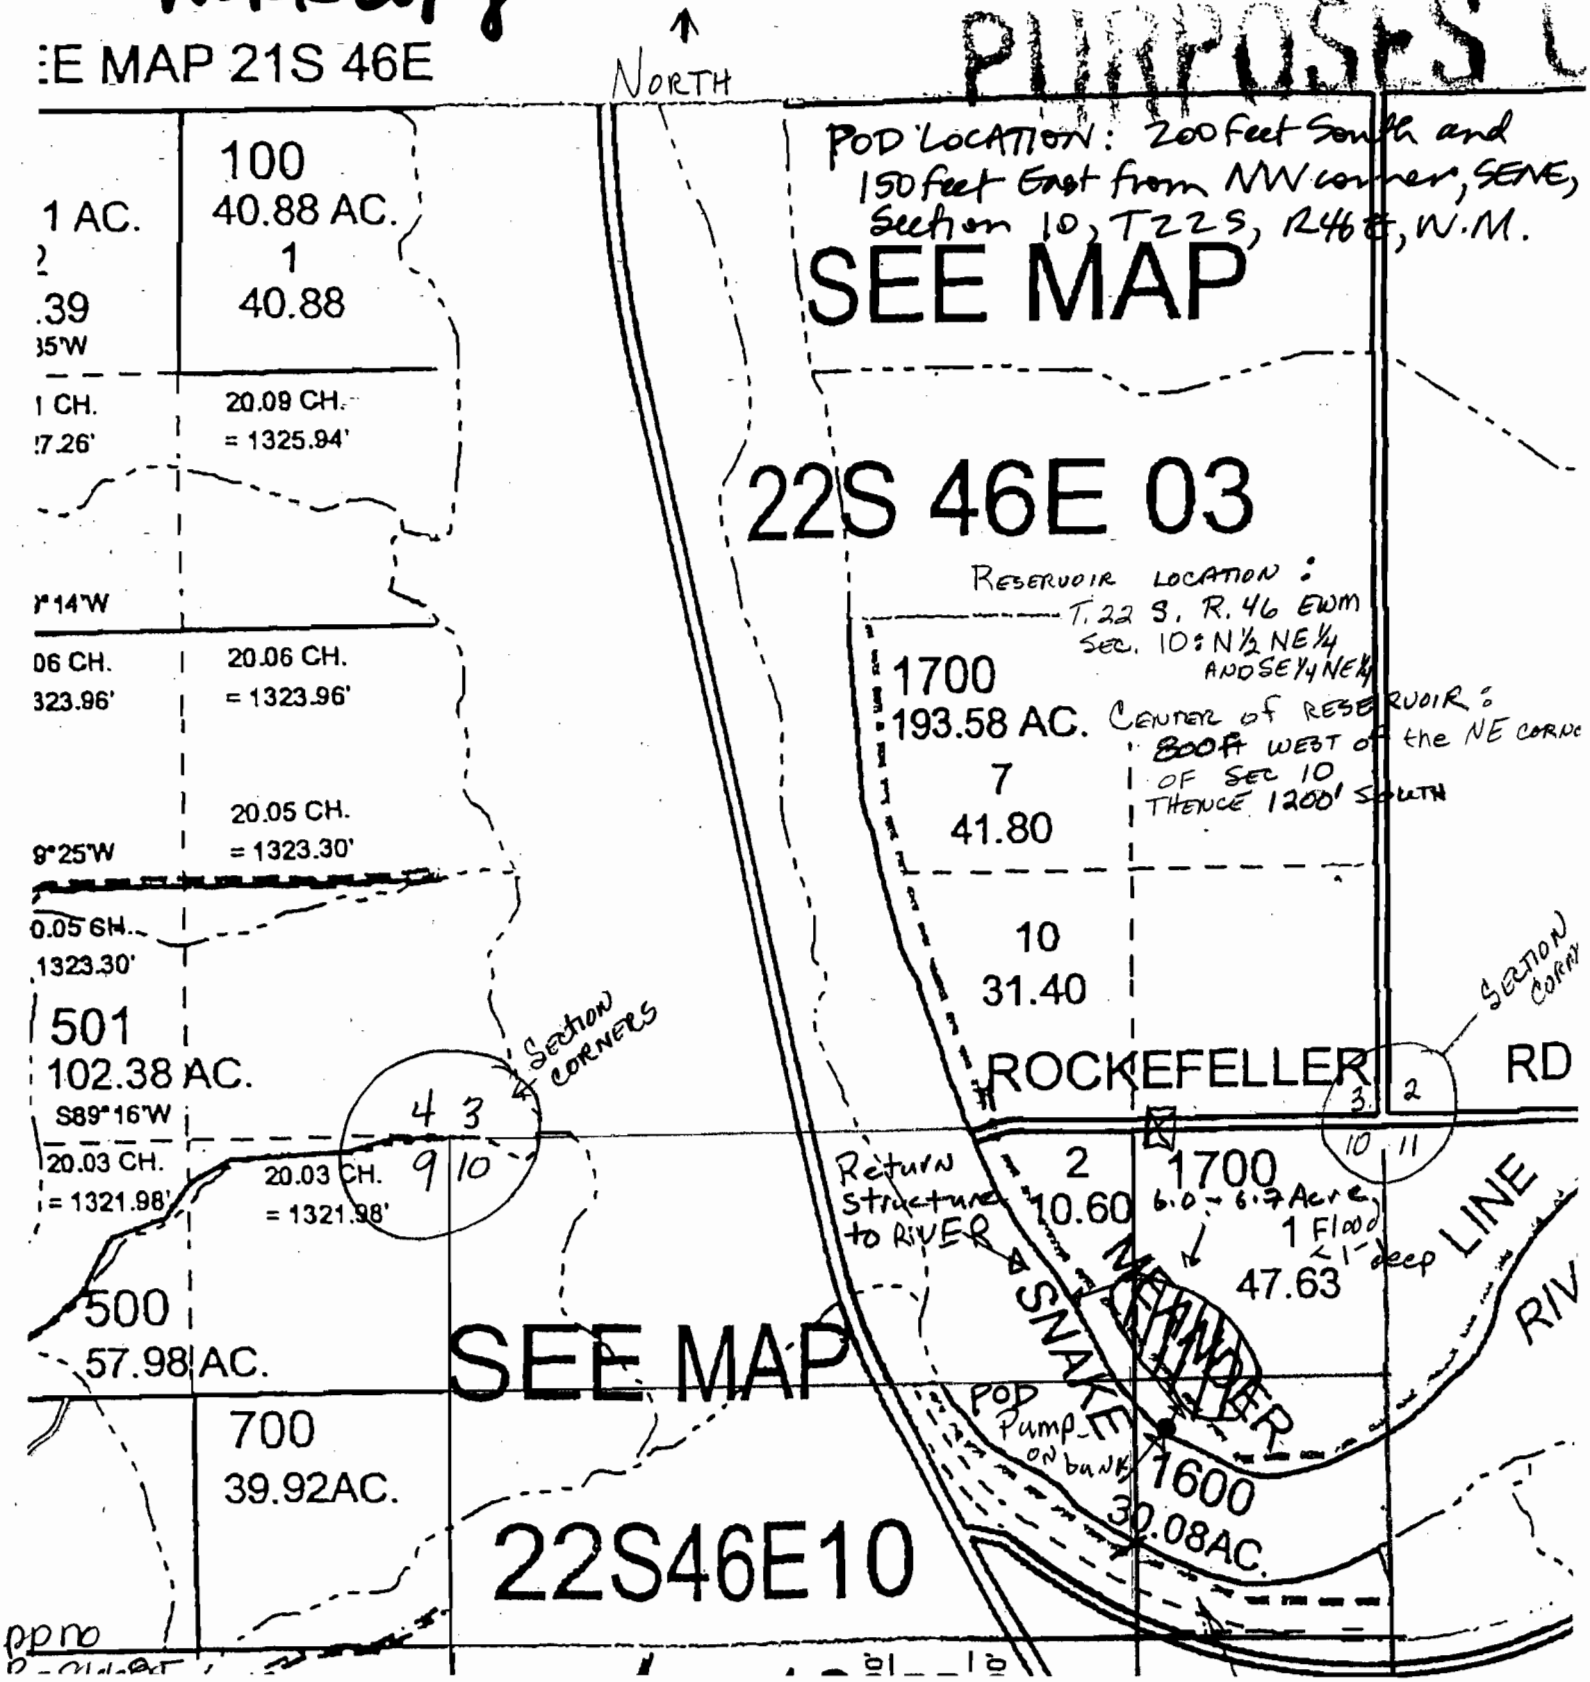
FOR ... PURPOSES ...