SCALE 2.4" = 1320'

BOOK 20

NE1/4 SEC 28 T.39S. R8W. W. M.
JOSEPHINE COUNTY
~~1"=200'~~

39 8 28 A

This map was prepared for assessment purpose only.

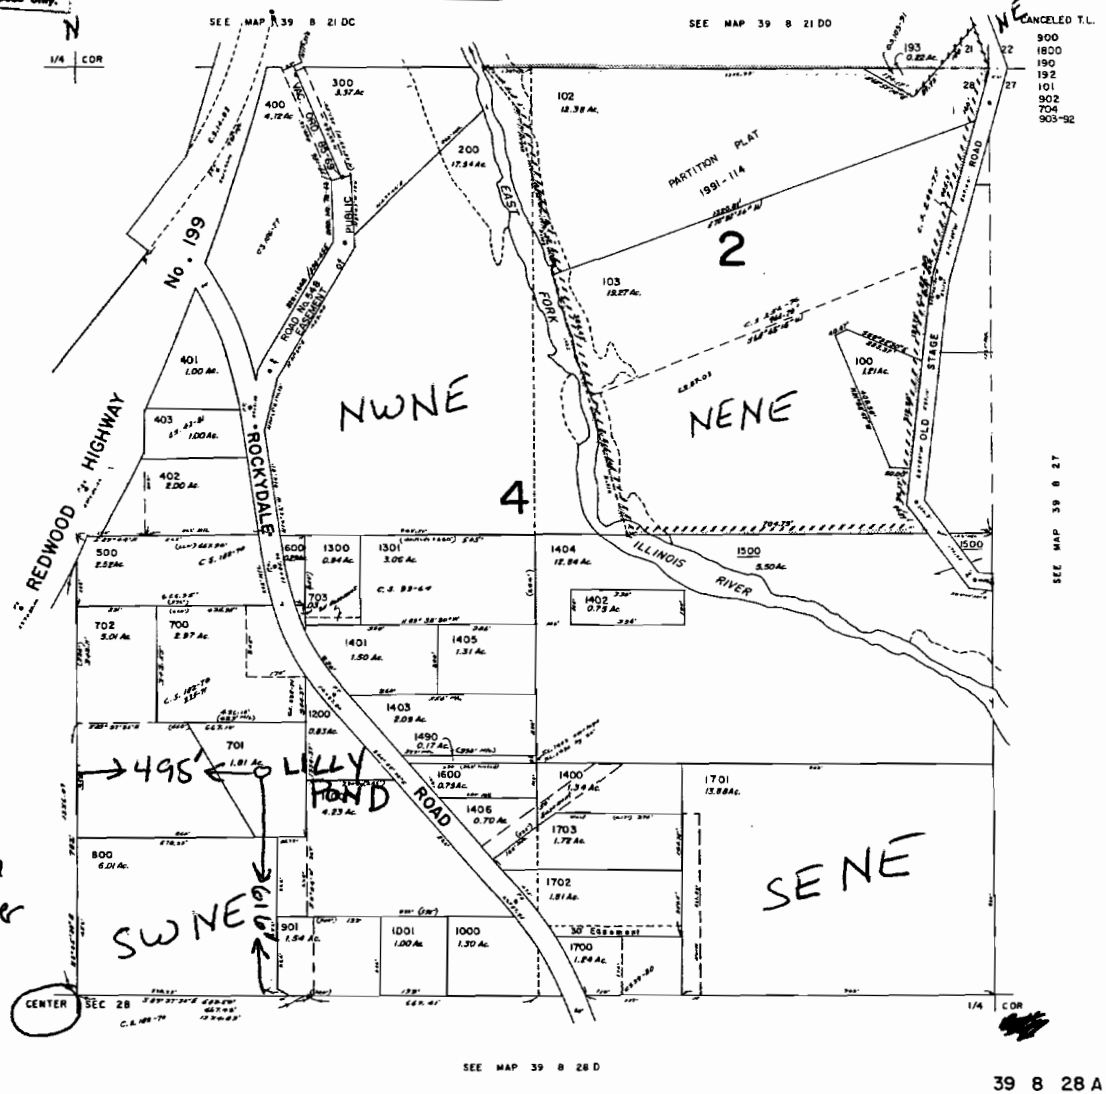

39 8 28 A

495' East
and
616' North
from center
of Section
28

N

RECEIVED
OCT 06 2006
WATER RESOURCES DEPT
SALEM, OREGON

app no R 86696