

10 1W 17
SCIO


8 9
17 16

Scale 1" = 400'



NE COR.
JOSEPH BOYCE NOT. 4377
& SE 1/4, NE 1/4, SEC. 17

SEE MAP 10 1W 16

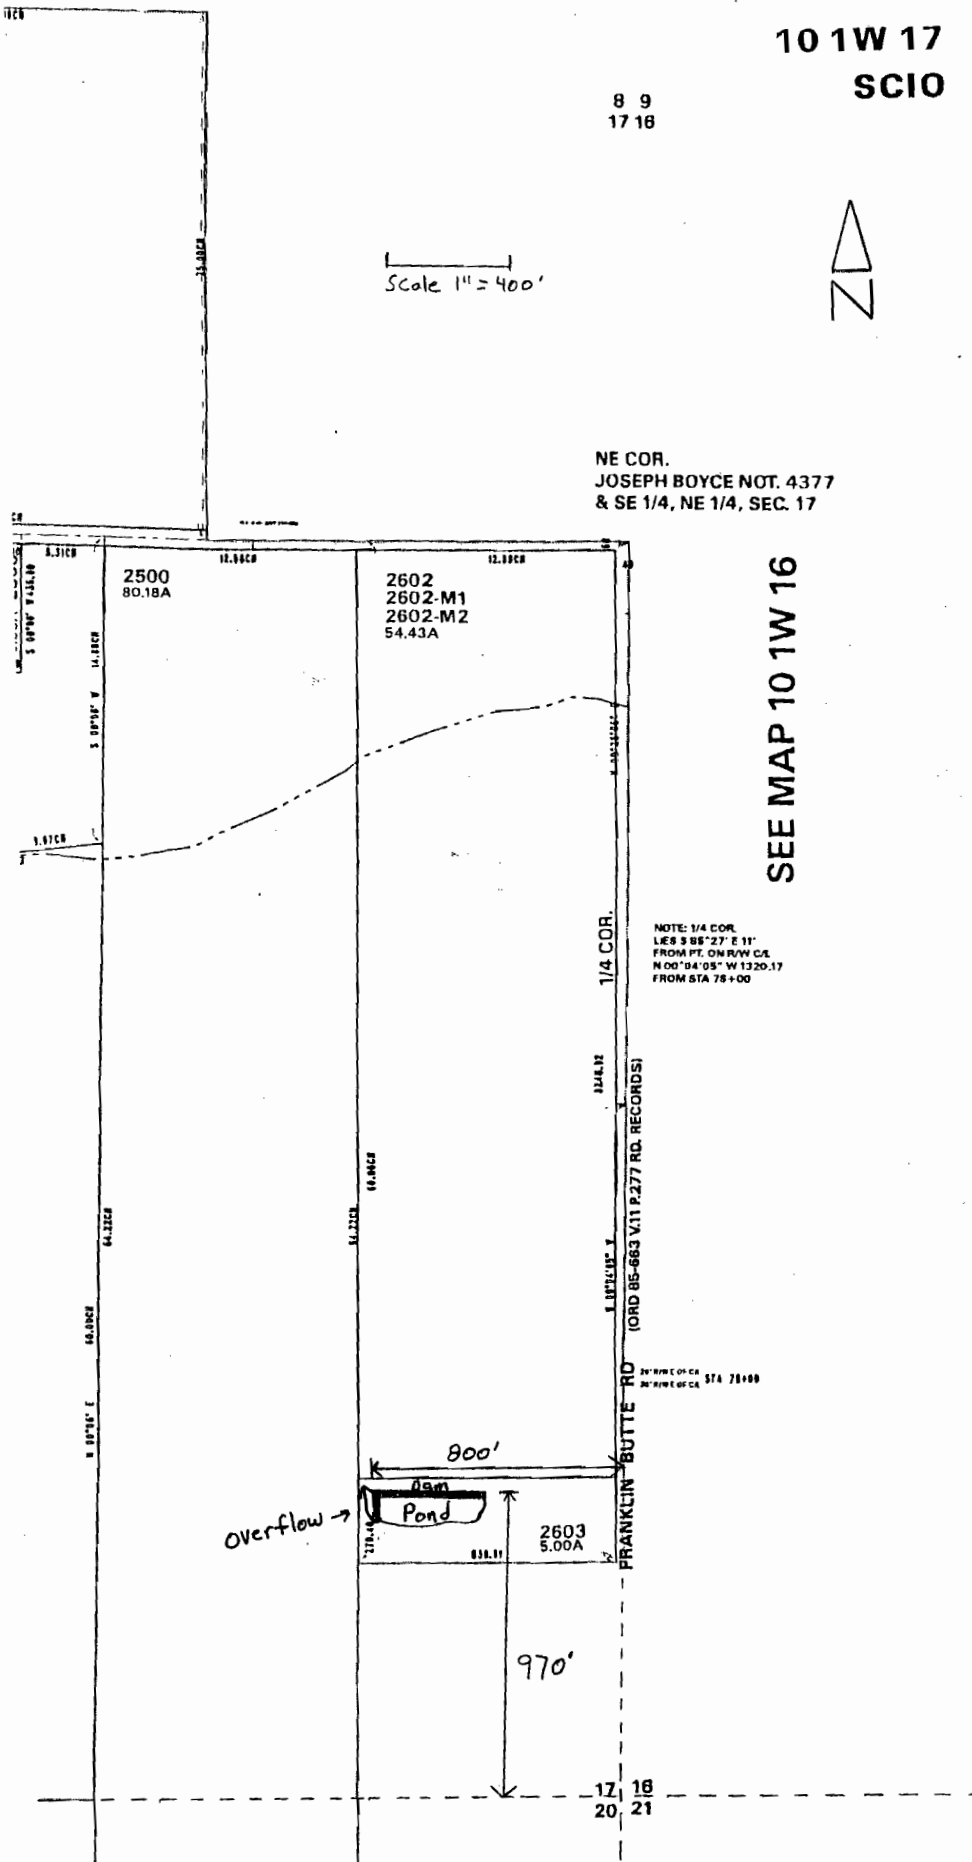

NOTE: 1/4 COR.
LES S 88° 27' E 11"
FROM PT. ON R/W C/L
N 00° 54' 05" W 1320.17
FROM STA 78+00


Pond To Be used To
irrigate From Time to
Time, any and all parts
of Tax Lot 2603

RECEIVED
NOV 02 2006
WATER RESOURCES D
SALEM, OREGON