


Site Location: NE $\frac{1}{4}$ of Section 7; T.34S.; R.5W.; W.M.; Tax Lot 116

Pond Location in Section 7: Pond #1 is 4,224' east and 3,696' north of SW corner of Sec. 7 and 584' south and 792' west of NE corner of Sec. 7. Pond #2 is 3,432' north and 806' west of SE corner of Sec. 7. and 4382' east and 1,848' south of NW ^{corner of} Sec. 7.

CORRECTED ADJUSTED
APPROX SCALE
1" = 1000 FEET



Scale: $\frac{5}{8}$ " = ~~1~~ mile
1" = 1,000'

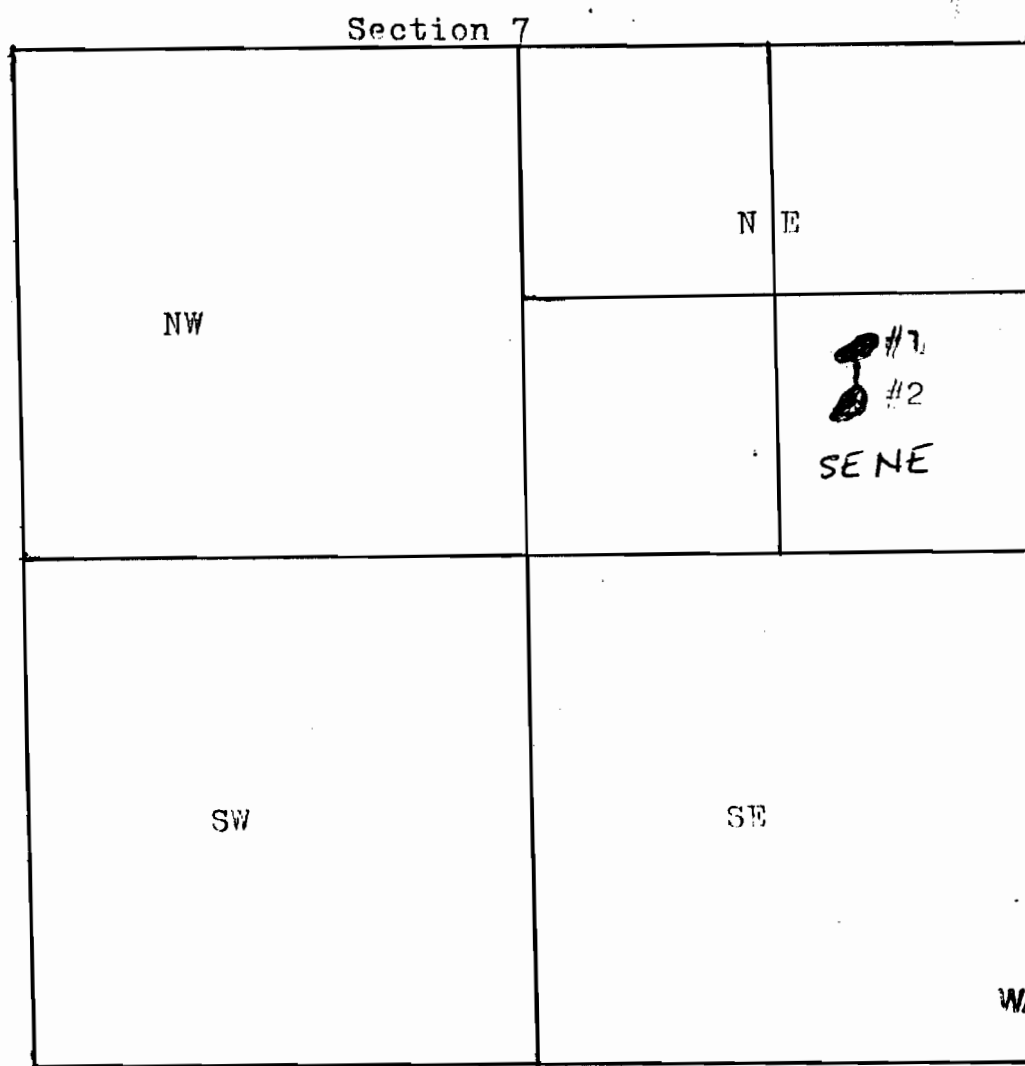

RECEIVED

FEB 08 2007

WATER RESOURCES DEPT
SALEM, OREGON