


T 39 S, R 19 E, WM

LAKE COUNTY, OREGON

TAX LOT 39-19-7800

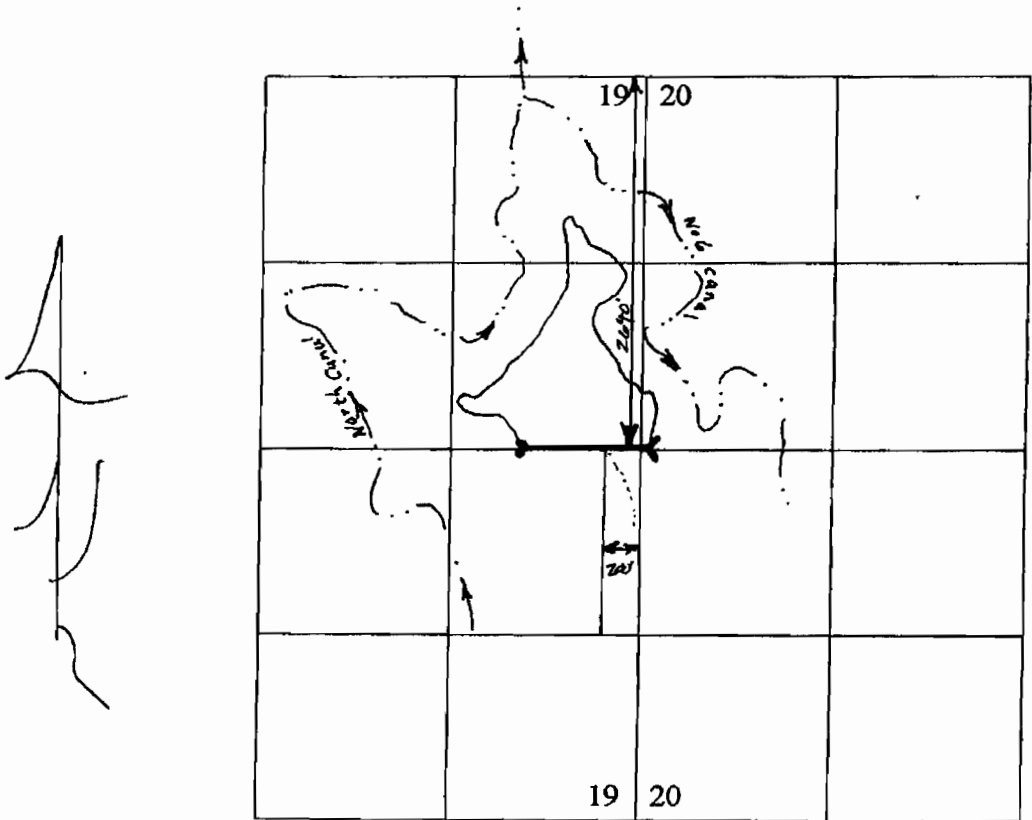

Dam 2640' S ; 200' W from the NE Corner
Sec 19

SCALE - 1" = 1320'

Revised 5/25/07
DR6-agent.

R 86875