


# Alternate Review Application Map

T5S, R31E T5S, R31E, Sec. 23  
Tax Lot 5S31000002700  
Umatilla County, Ore

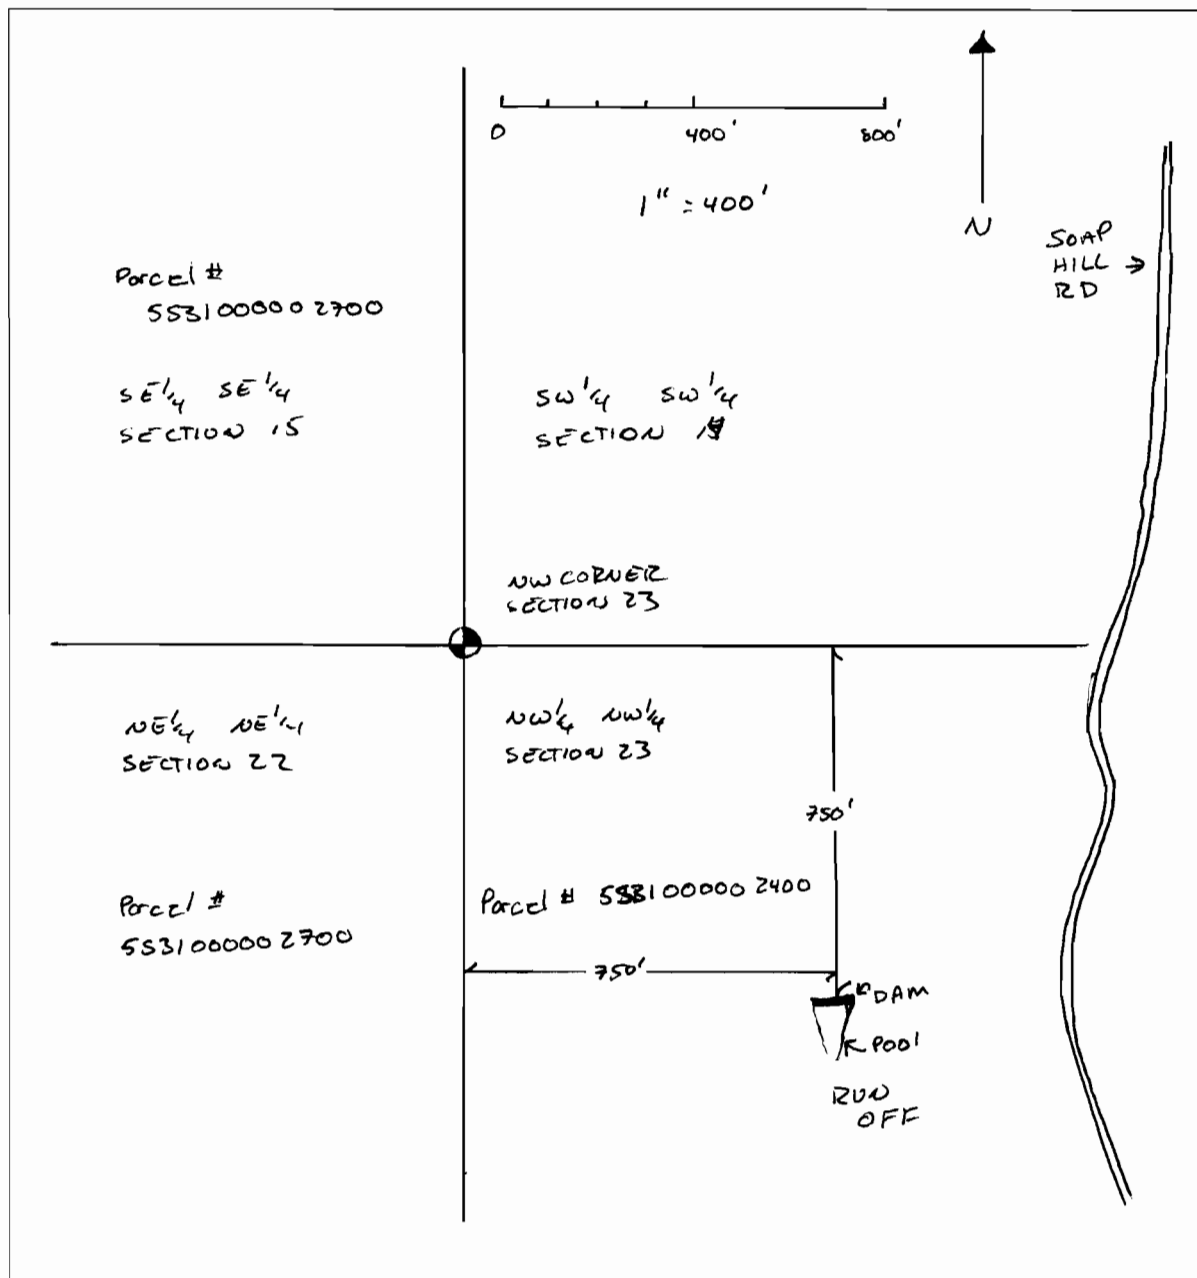

**RECEIVED**

JUN 01 2007  
WATER RESOURCES DEPT  
SALEM, OREGON

**RECEIVED  
OVER THE COUNTER**