


T. 39 S., R. 8 W., W.M.  
 Scale 200' = 1"      Oct. 1952  
 Fred M. Linkhart.

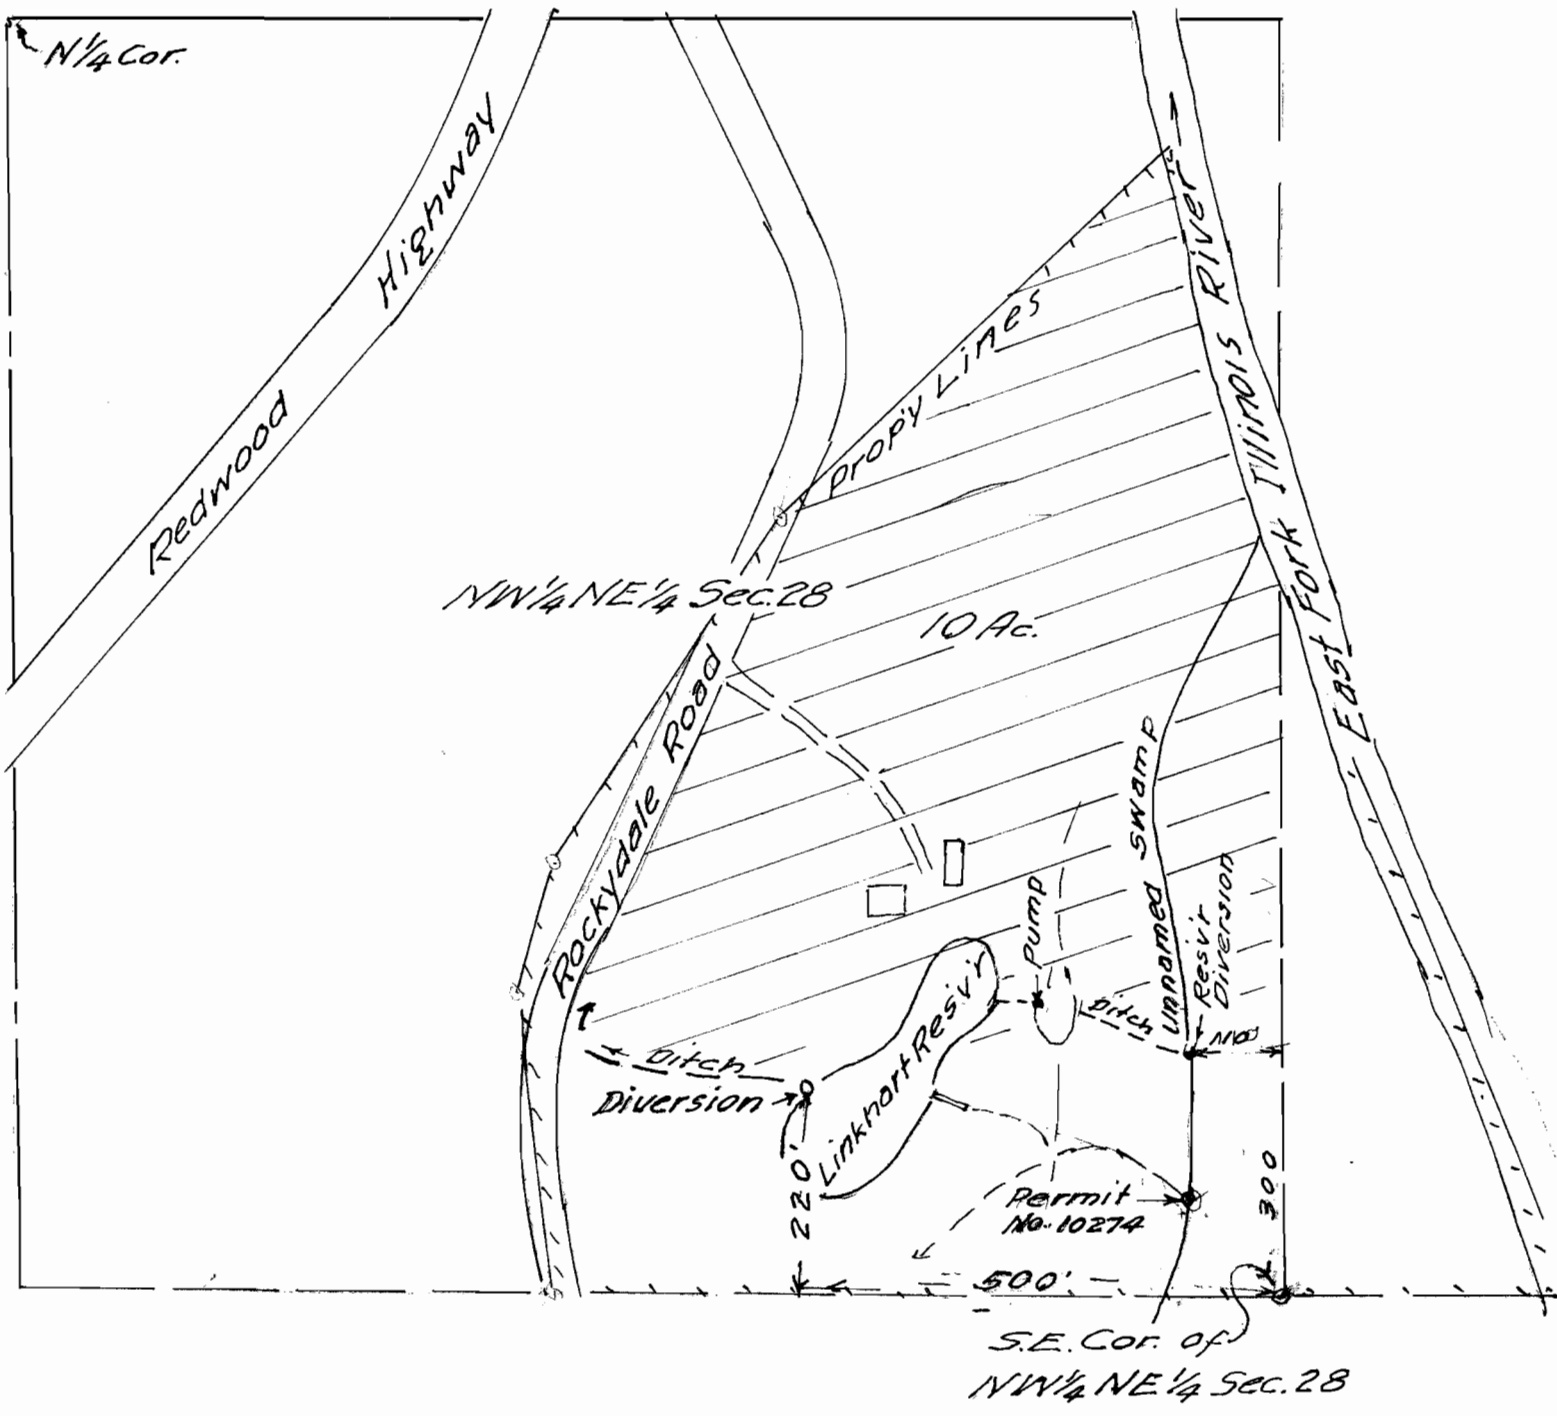

Application No. R-27746  
 27747  
 Permit No. R-1750  
 21850