


Dam #2

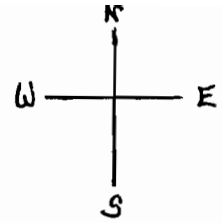


N 1/4 Corner
Sec. 35
T135 R30E W.M.

RECEIVED

MAY 14 2007

WATER RESOURCES DEPT
SALEM, OREGON

Tax lot 600

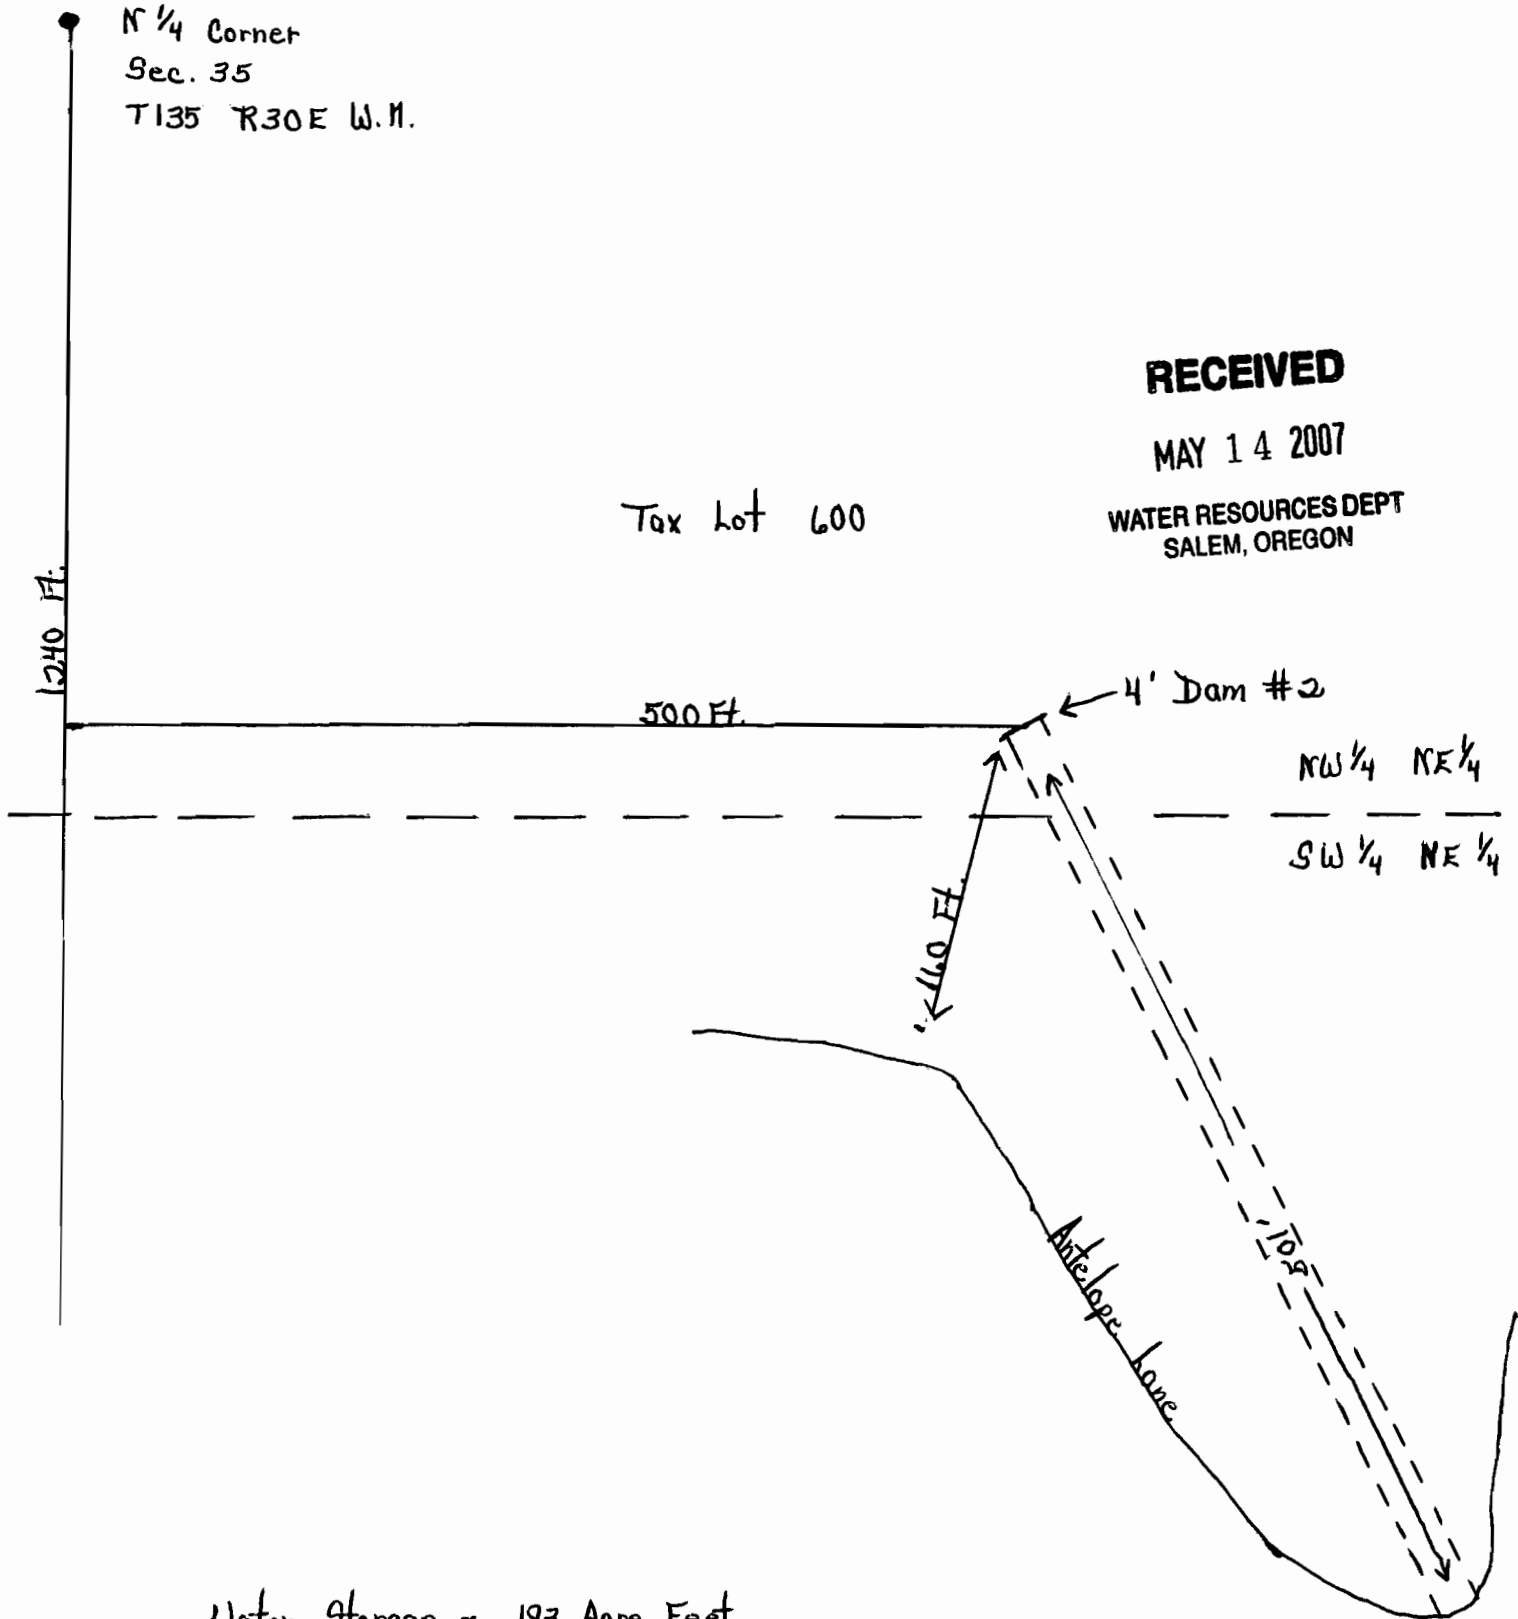

Water Storage - .183 Acre Feet
Scale 1" = 100'

app no R-86859