


T 39 S
R 5 W
Sec 24

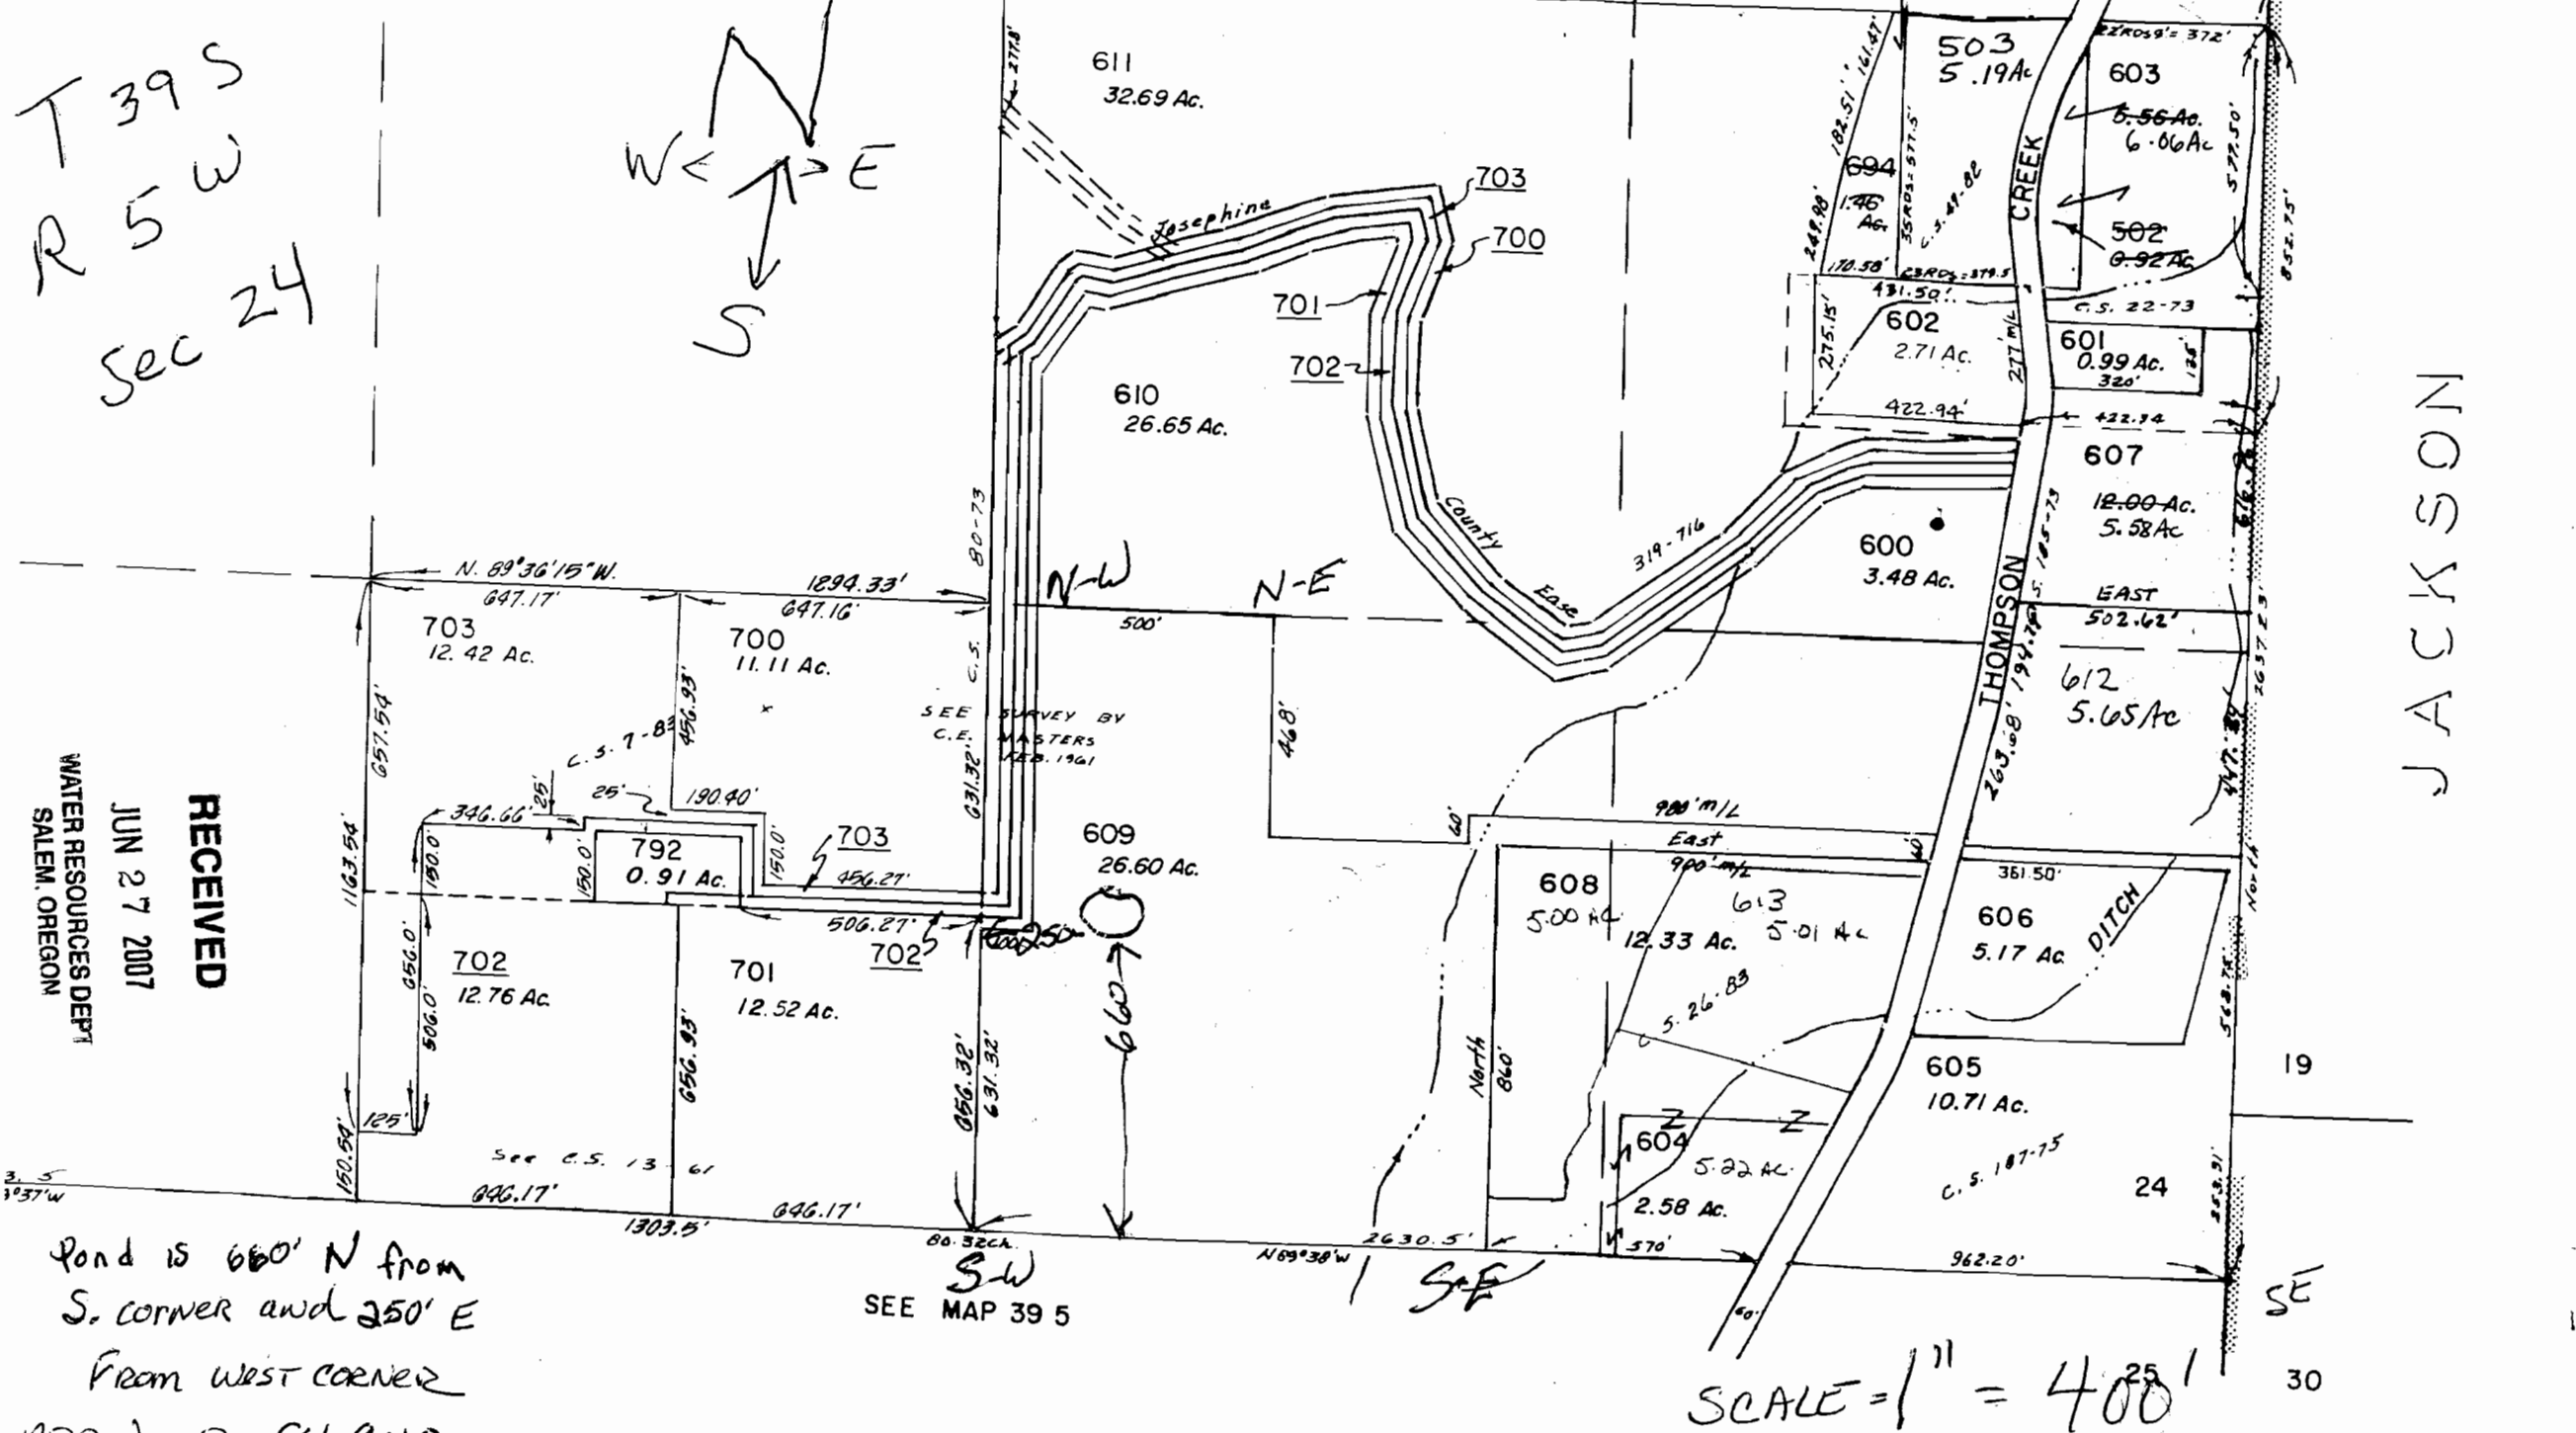

RECEIVED
JUN 27 2007
WATER RESOURCES DEPT
SALEM, OREGON



JACKSON

Pond is 660' N from
S. corner and 250' E
From west corner
APP No R 86940

SEE MAP 39 5

SCALE = 1" = 400'

39 5 24