

Alternative Reservoir Application

TRANSFER APPLICATION

FOR: SAM DEMENWELL *Demanett*

BY: DUANE W. KIRBY

T19S, R2W, W. M.

SECTION 18

CERTIFICATE NO 44515

TAX LOT 504

Pond is 980' E
and 900' S from
N 1/4 cor Sec. 18

50

COUNTY RD 937

N 1/4 Cor

BEAR CREEK

LOT 505

7.6 ACRES

LOT 503

old div. pt.
0.4 ACRES

1.0 ACRES

STATE HWY 222

POND

TAX LOT 504

NW 1/4 NE 1/4

RECEIVED

AUG 20 2007




WATER RESOURCES DEPT
SALEM, OREGON




SCALE: 1" = 400'

EXISTING DIV. PT. 530 FEET SOUTH & 1270 FEET EAST FROM N 1/4 COR, SEC 18
TO REMAIN

POND 860 FEET SOUTH & 1070 FEET EAST FROM N 1/4 COR, SEC 18

-  8.0 ACRES TO REMAIN
-  1.0 ACRES FROM LOT 503
-  1.0 ACRES TO LOT 504

THE PURPOSE OF THIS MAP IS TO IDENTIFY THE LOCATION OF THE WATER RIGHT. IT IS NOT INTENDED TO PROVIDE INFORMATION RELATIVE TO THE LOCATION OF PROPERTY OWNERSHIP BOUNDARY LINES.

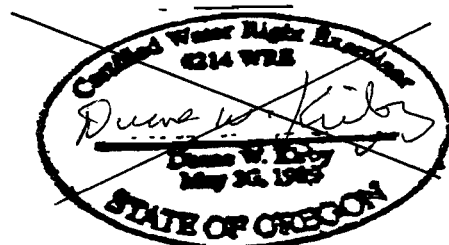

appno R-86960