

THIS MAP WAS PREPARED FOR ASSESSMENT PURPOSE ONLY


NE1/4 SW1/4 SECTION 06 T.01S. R.10E. W.M.
HOOD RIVER COUNTY

01S 10E 06CA

1"=200'

SCALE IN FEET
0 100 200

ADJUSTED COLLECTED
APPROX SCALE 1" = 200 FEET.
SEE MAP 01S 10E 06BD

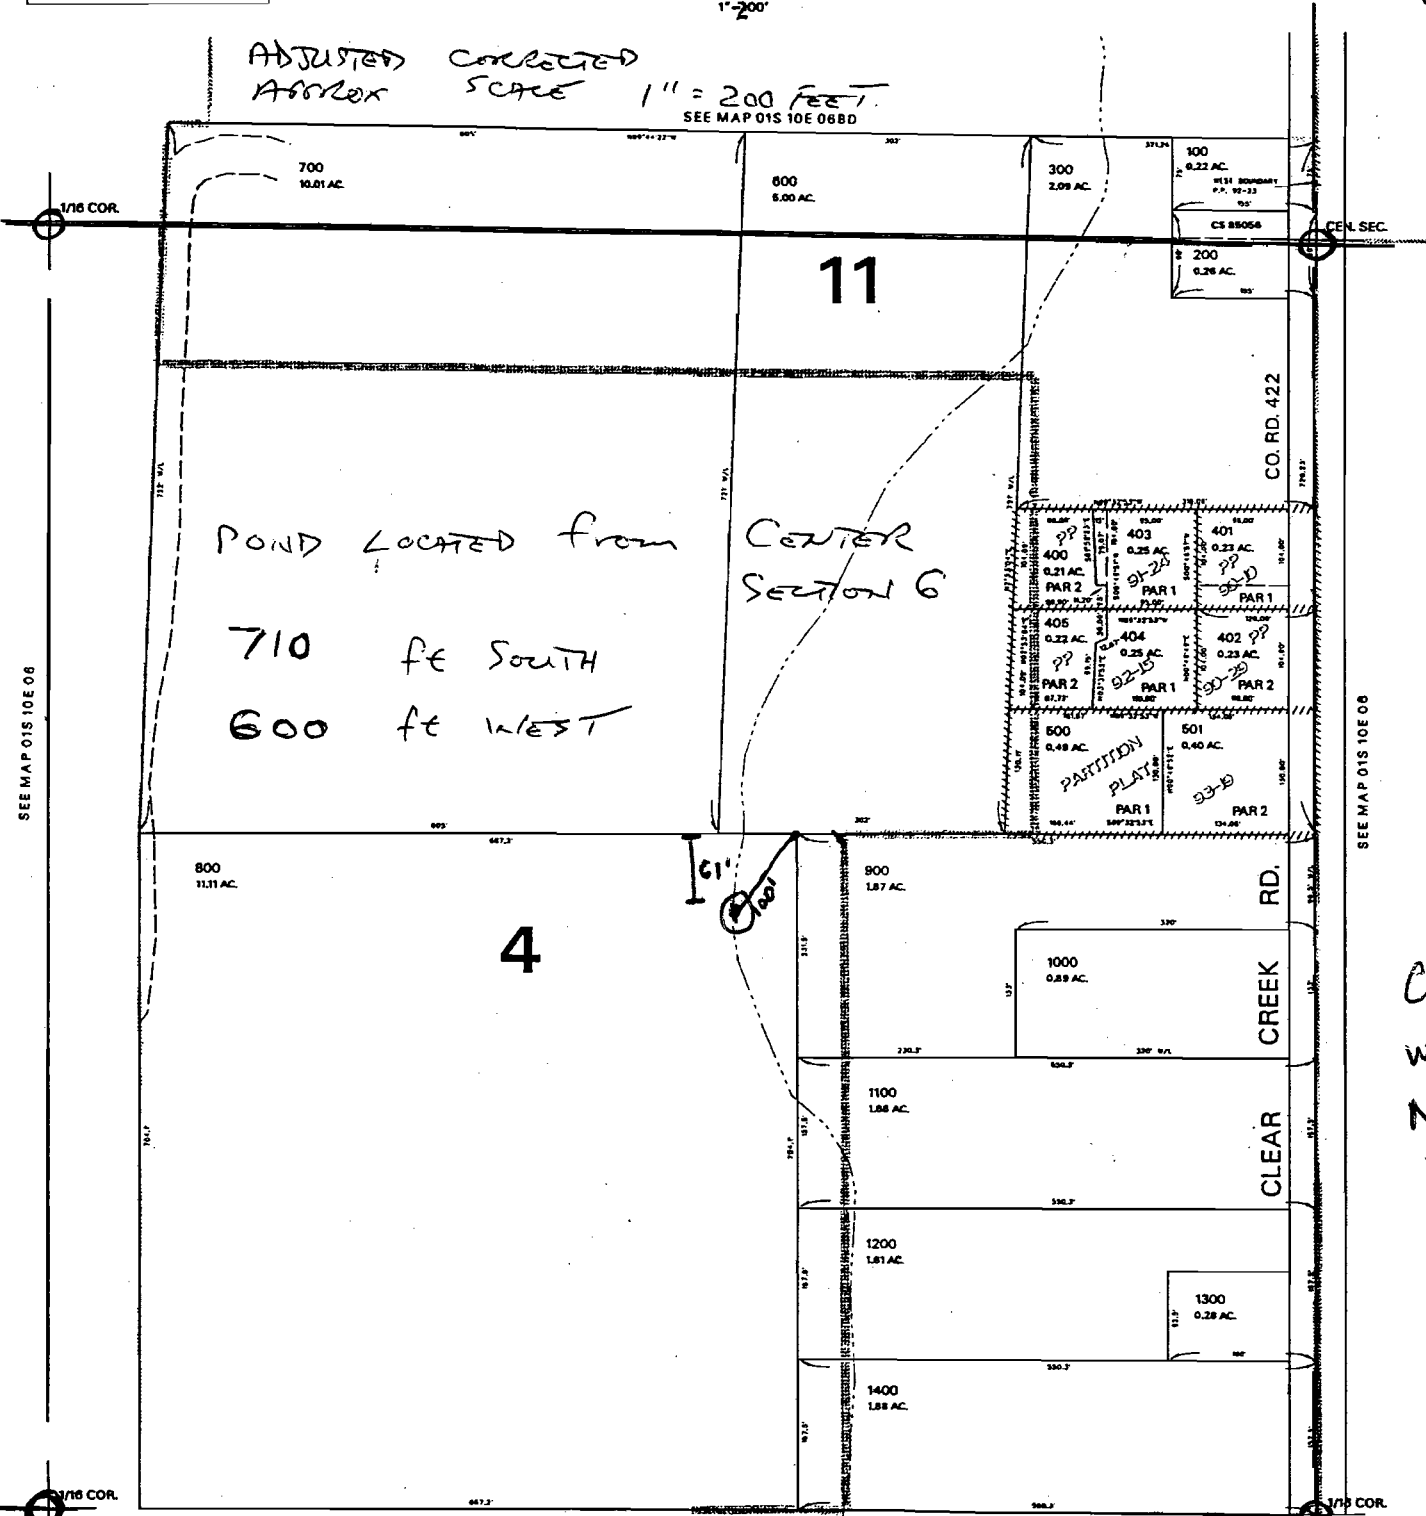

Center of reservoir
will be 100ft. from
NE corner of tax
lot 800 and 61f
south of the
north line of
tax lot 800
or
see attached
exhibit A

RECEIVED

REVISED: JD
01/23/03