


Feb 15 08 02:09p

P.2

T2N R10E Sec 24, Hood River County  
Tax Lot 4404  
1" = 600'

Dam is 2340' North and  
600' West of the SE corner  
of section 24 being in the  
NE SE Sec. 24

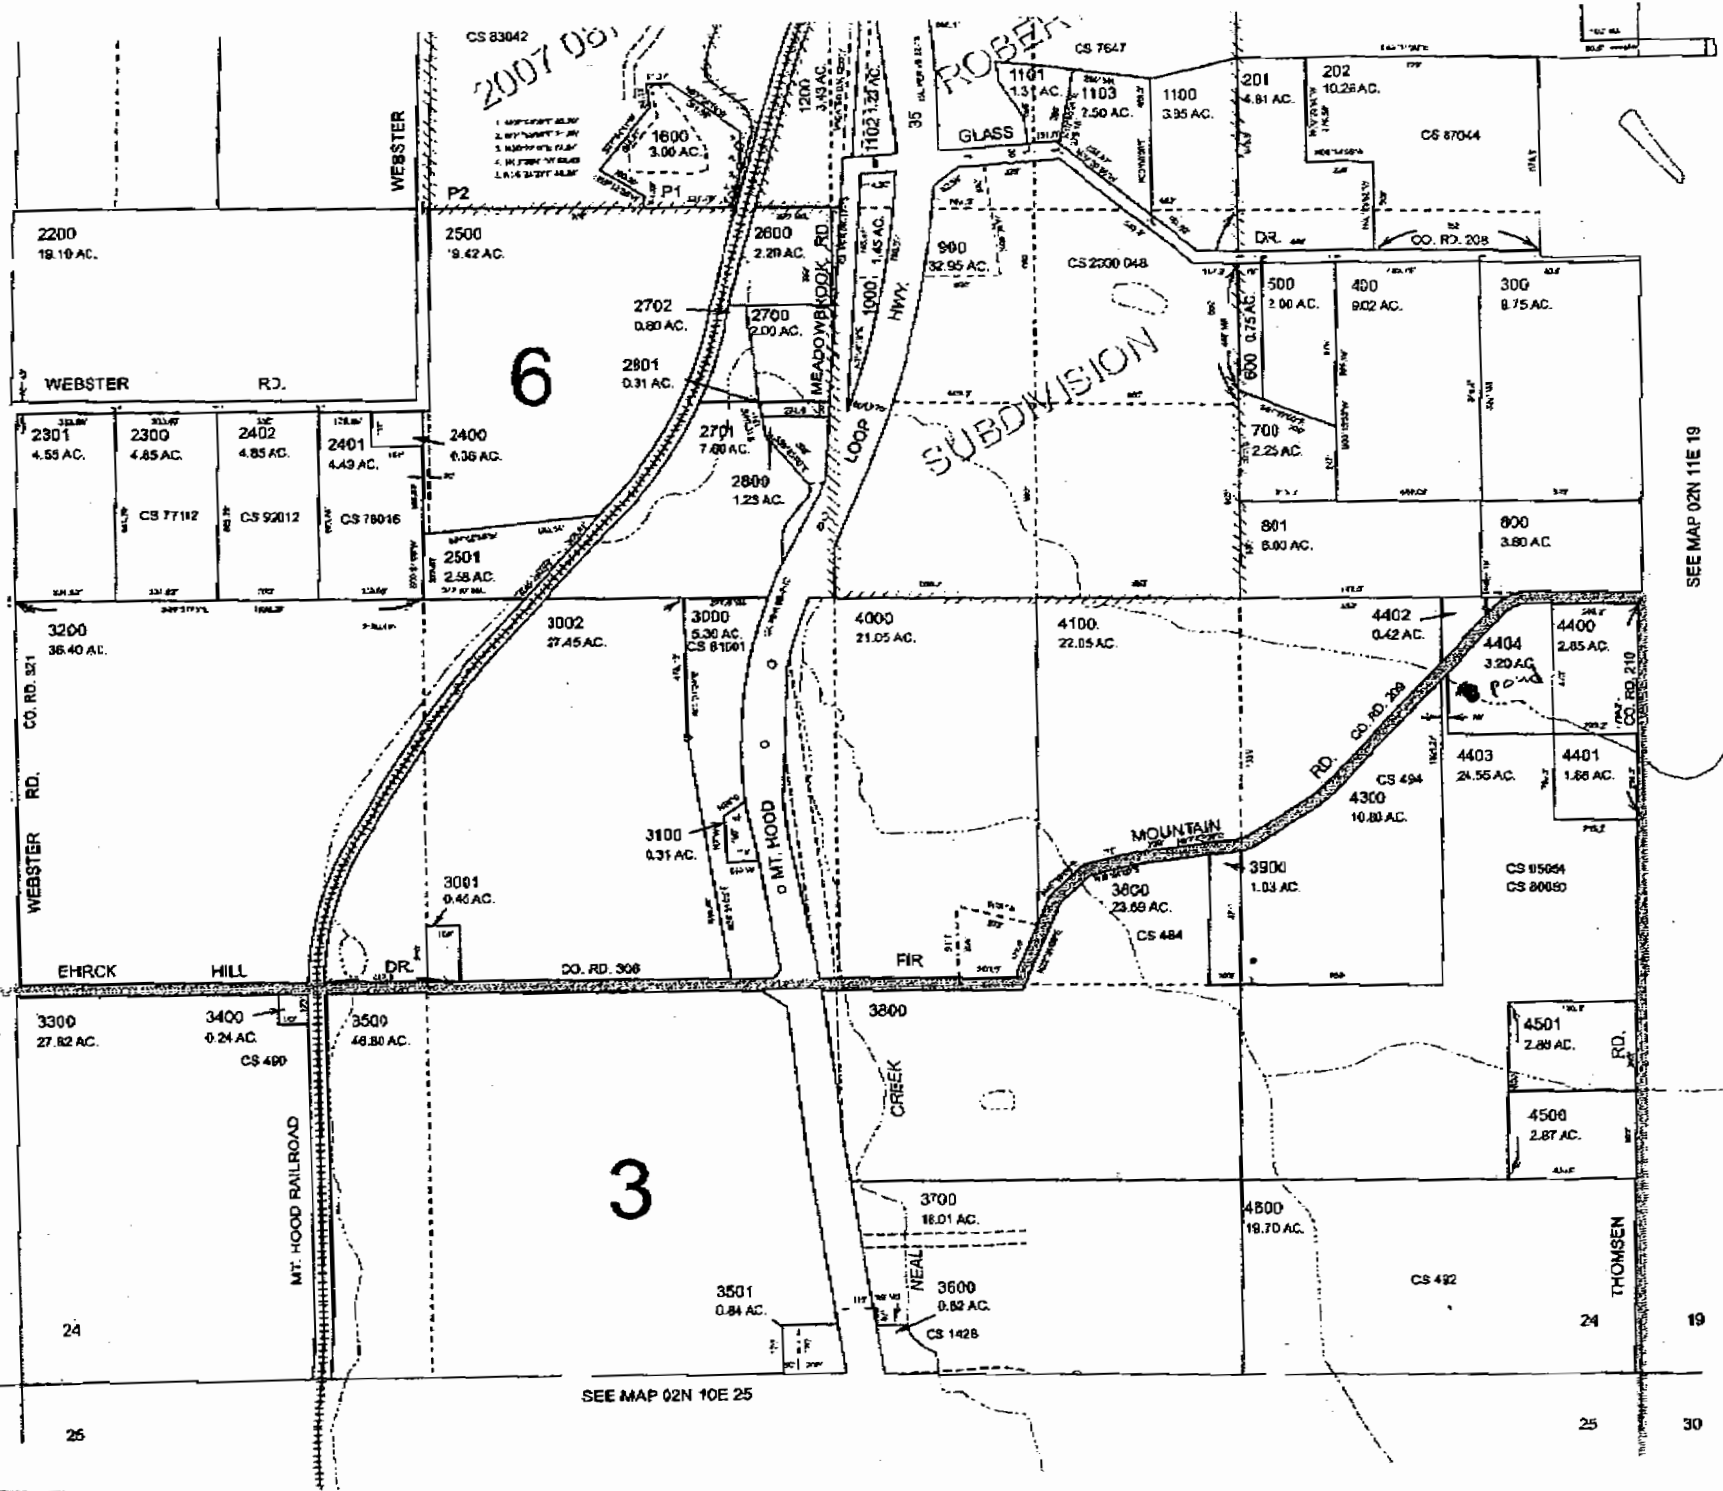

SEE MAP 02N 11E 19

SEE MAP 02N 10E 25

App No R 87087