


This map was prepared for assessment purpose only.

SECTION 32 1.45. R. 1E. W.M.

D.L.C. JAMES SHIRLEY NO. 45

CLACKAMAS COUNTY

1" = 200' Approx SCALE
1" = 600 Feet

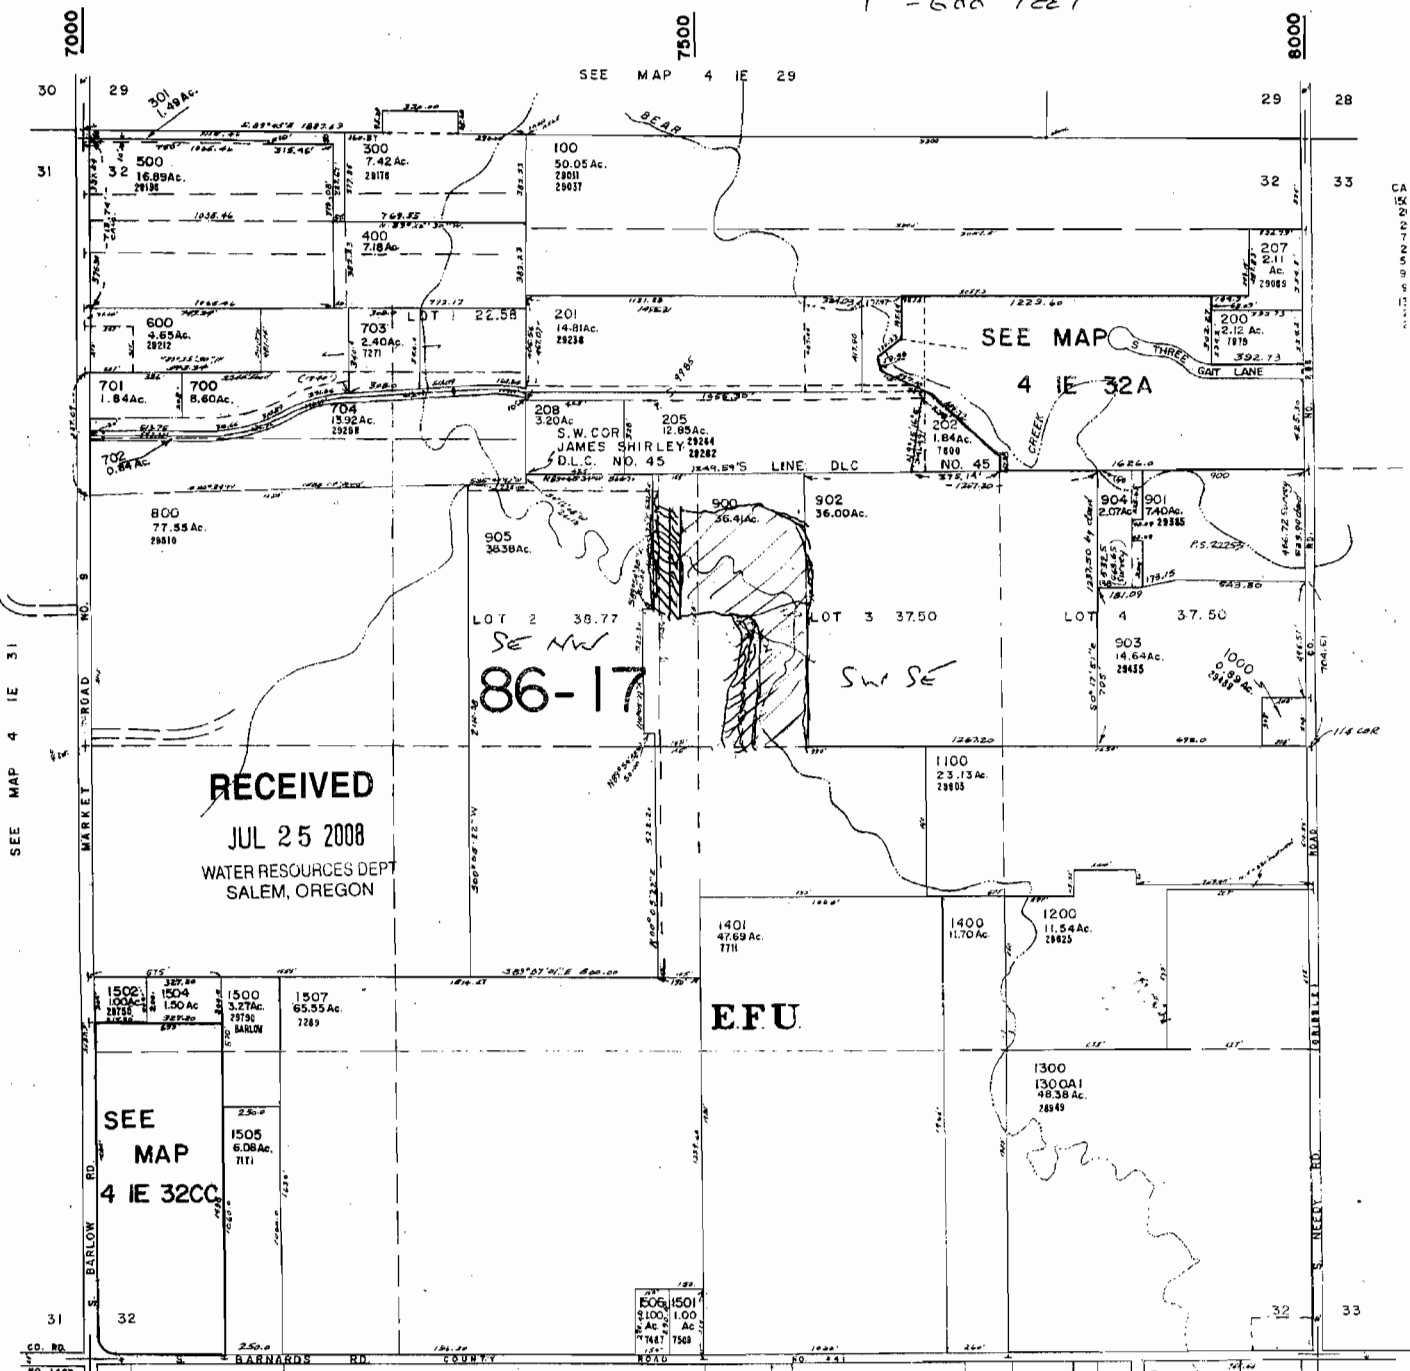

RECEIVED
JUL 25 2008
WATER RESOURCES DEPT
SALEM, OREGON

EFU

SEE
MAP
4 IE 32CC

APL 7/25/08

SEE MAP 5 IE 3

CENTER OF RESERVOIR DAM LOCATED
FROM NW CORNER SECTION 32
2500 ft EAST
2025 ft SOUTH

App No R 87242