

# Township 39 South, Range 18 East, W.M.

All TAX LOT 1300

DRG 11/11/04


## DAM "A"

Point of Diversion -  
Center of Dam  
2,500' East & 100'  
North from the SW  
Corner, Section 7,  
T 39 S, R 18 E, WM

DRG 11/11/04

## DAM "B"

Center of Dam  
700' South & 400'  
East from the N<sup>1</sup>/<sub>4</sub>  
Corner, Section 18,  
T 39 S, R 18 E, WM

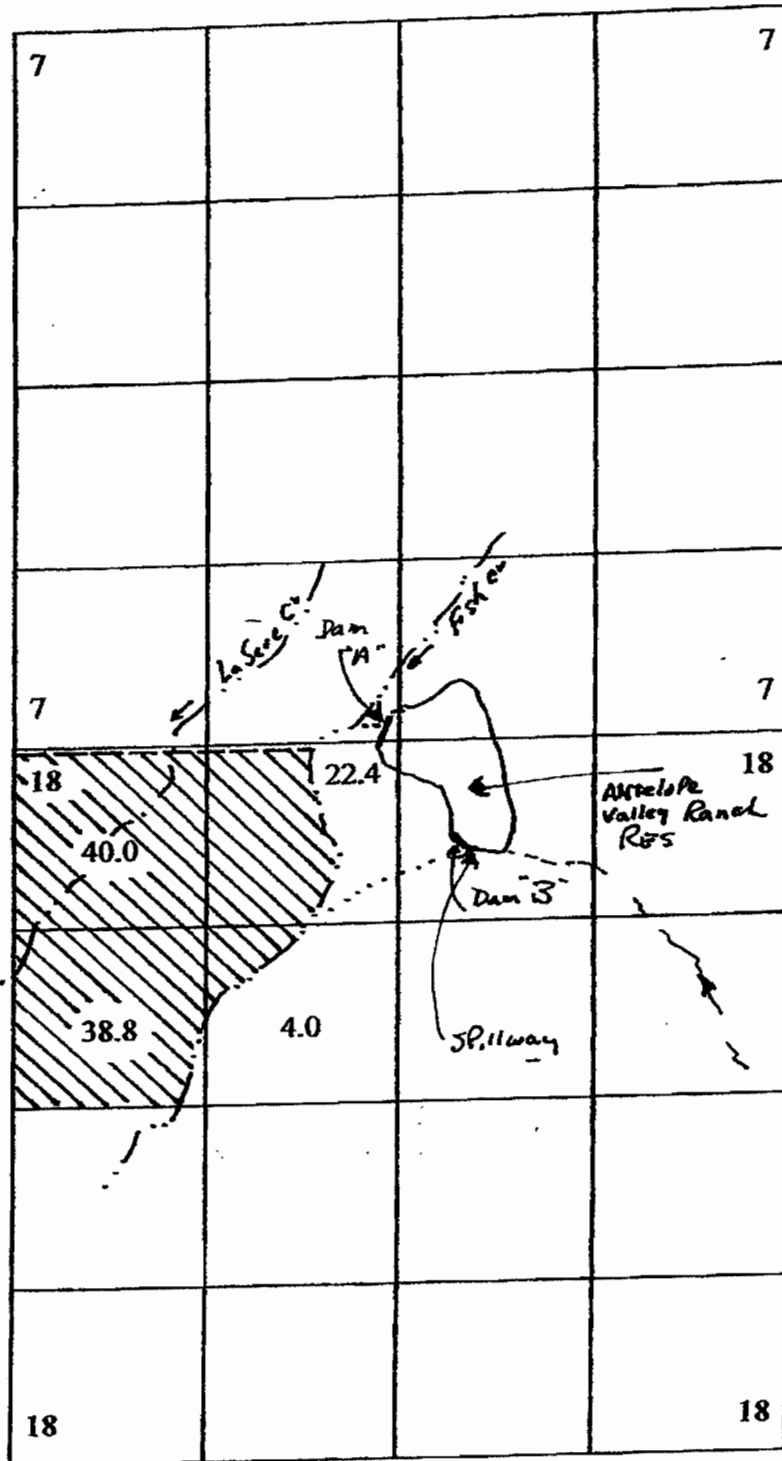

RECEIVED

NOV 11 2004

WATER RESOURCES DEPT  
SALEM, OREGON