


MAP 3: ROADS AND DRAINAGE

WORK
COPY

EHLERS TRACT
Sections 29, 32 & 33
T10S, R6W, Benton Co.
Map Scale: 1" = 600'
APPROX COLLECTED
ADJUSTED SCALE

- Surfaced roads
- - - Unsurfaced roads
- ★ Stream crossing structure
- ★ Drainage structure

1" = 500 FT.

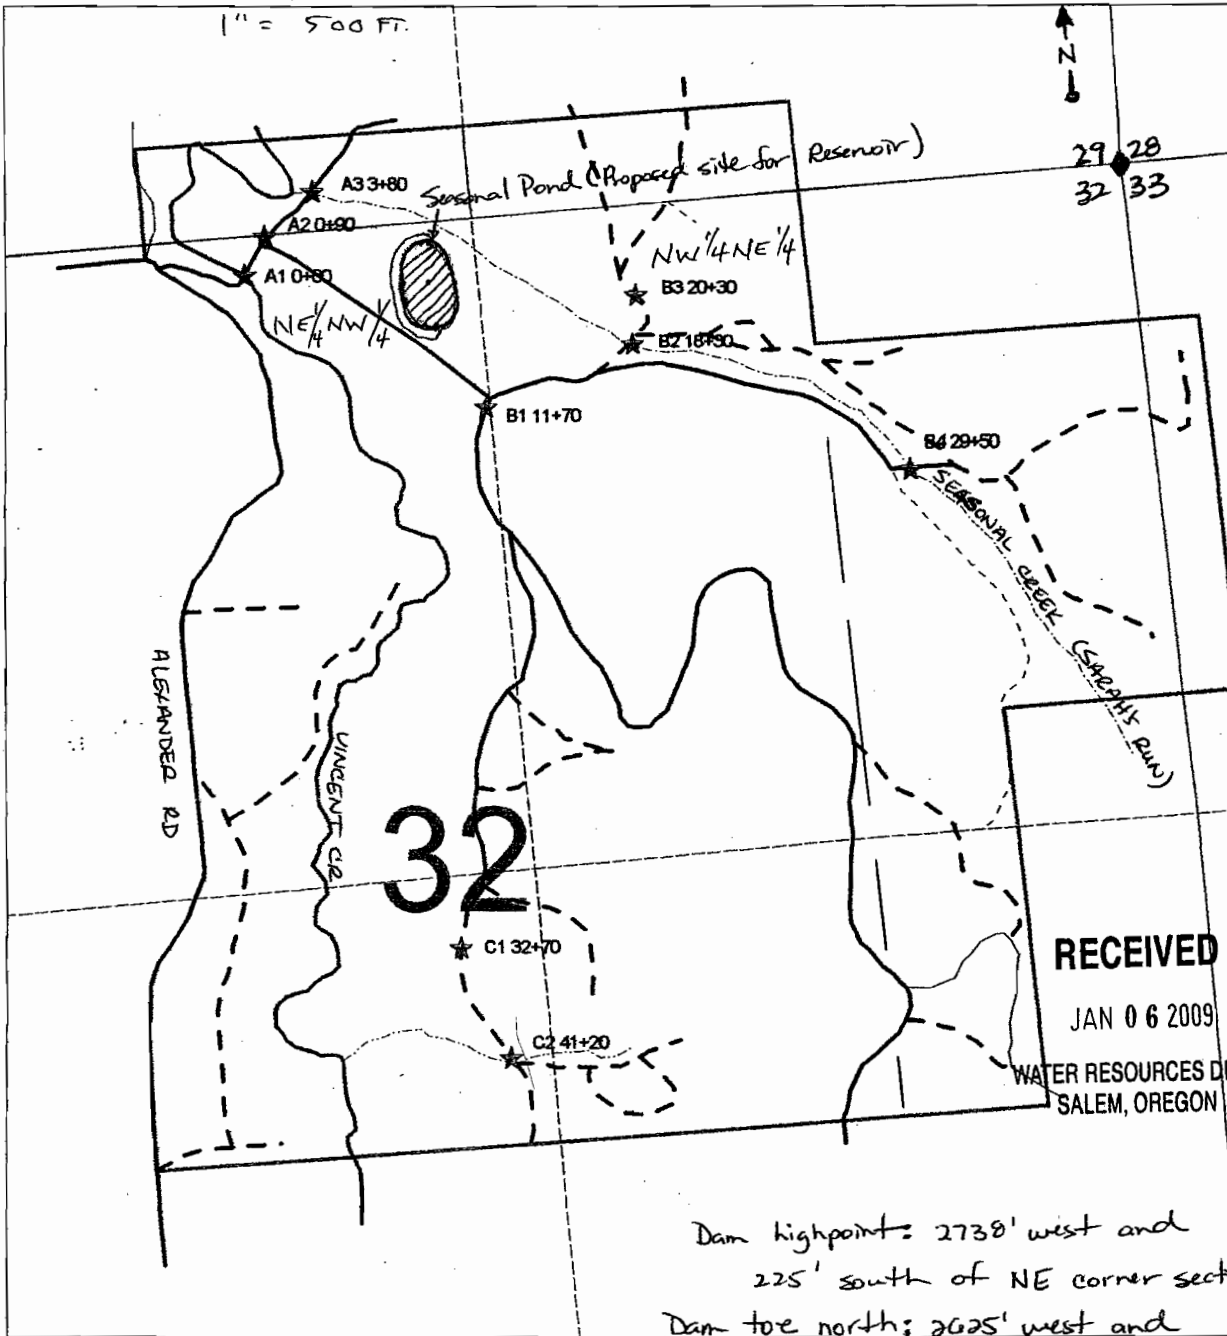

Dam highpoint: 2730' west and
225' south of NE corner section 32
Dam toe north: 2625' west and
75' south of NE corner section 32
Dam toe south: 2425' west and
375' south of NE corner section 32

POND: T10S
R6W
S32
NW 1/4 NE 1/4
Tax Lot #100