

SEC. 31 T.10S. R.4.W. W.M.
BENTON COUNTY

1" = 600'


SEE MAP 10 4 30

THIS MAP WAS PREPARED FOR
ASSESSMENT PURPOSES ONLY

10 4 31

REV: 05-13-

- CANCELLED

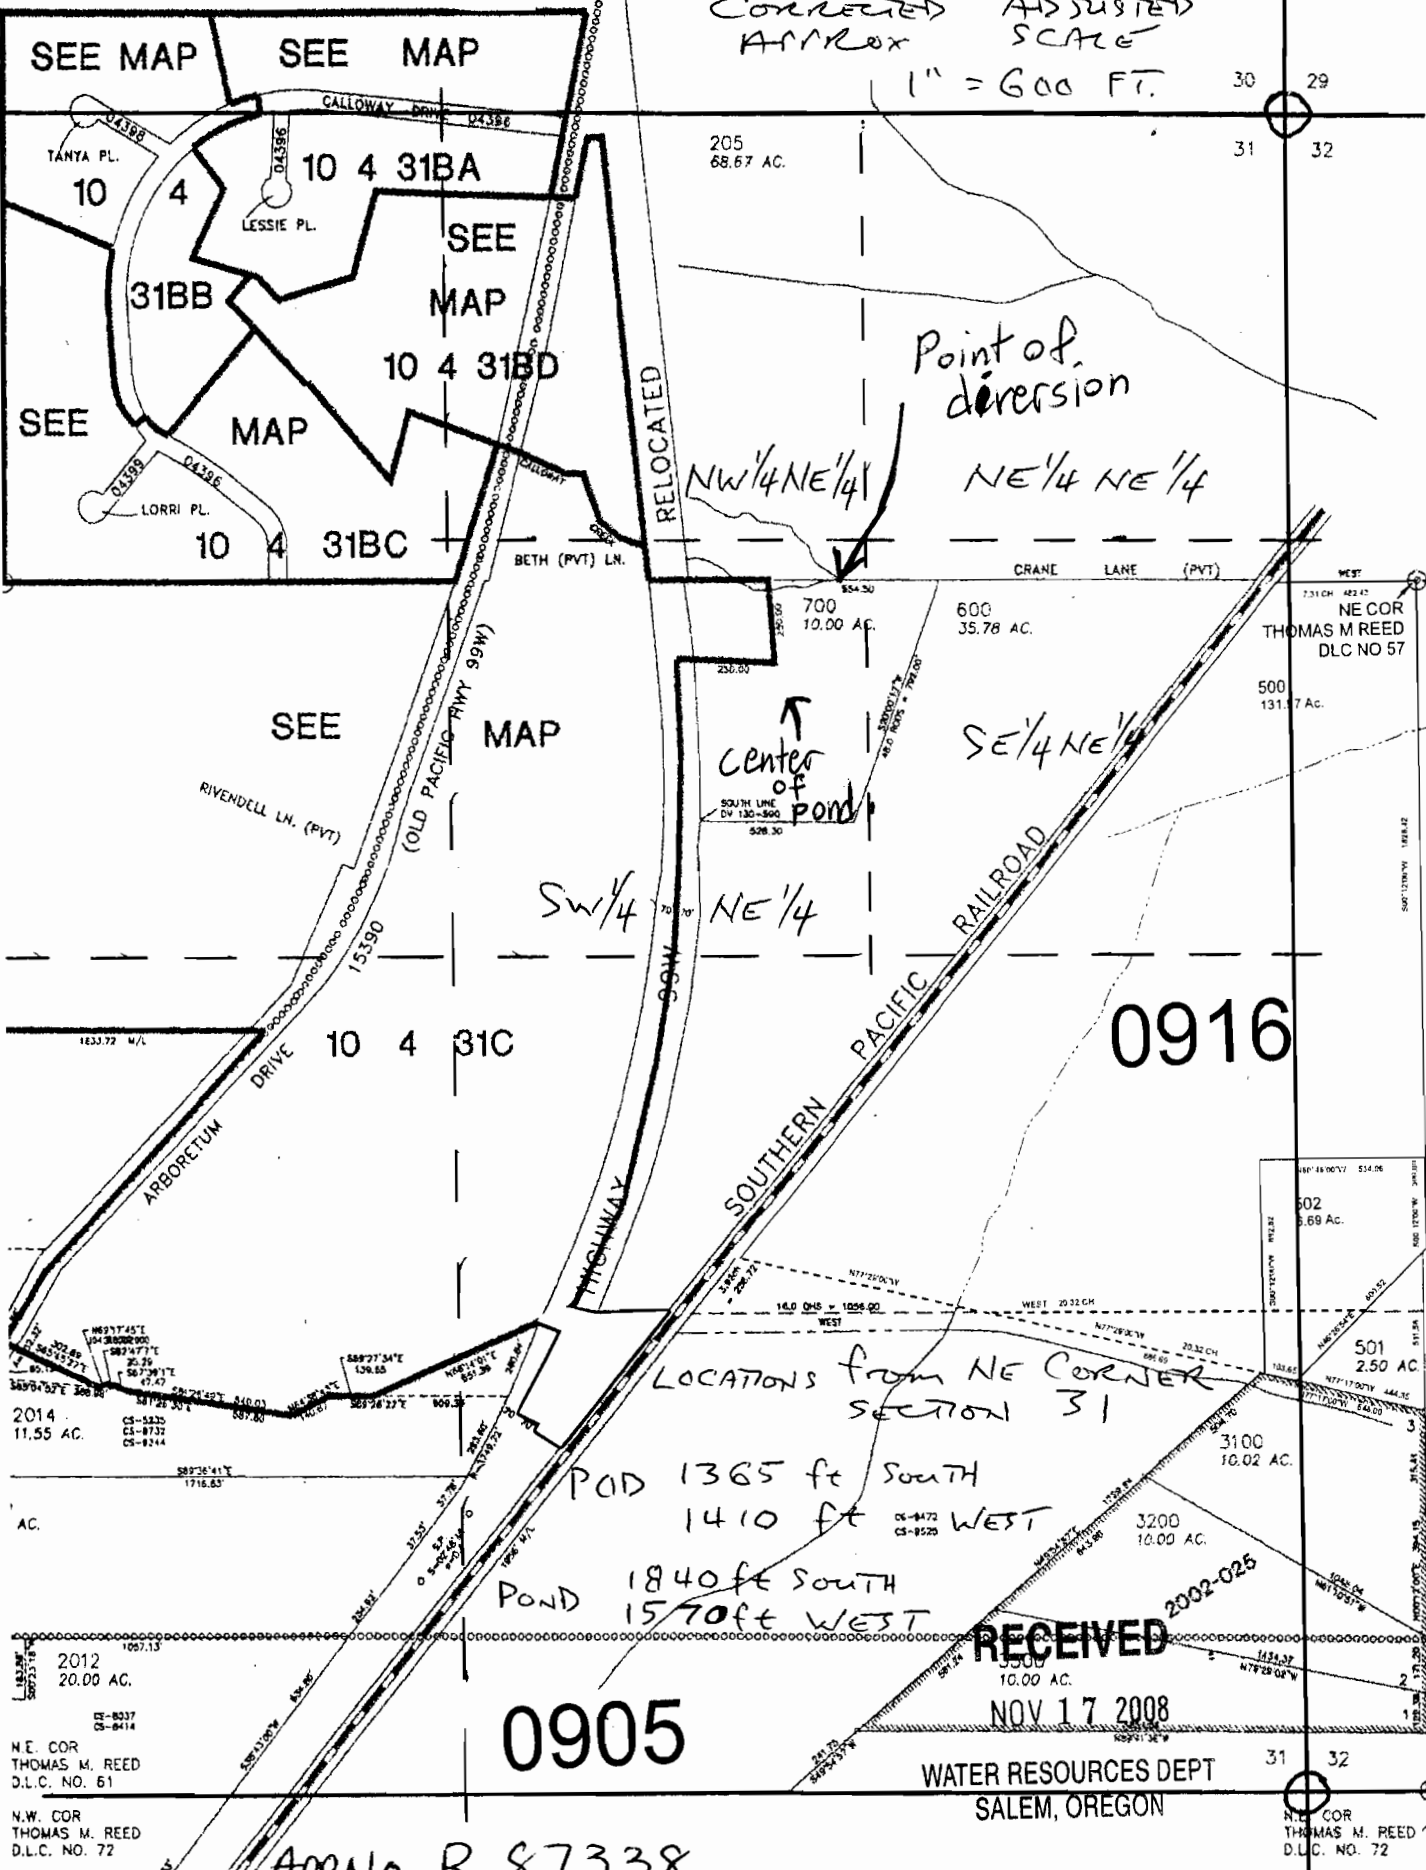

SEE MAP 10 4 32

0916

0905

RECEIVED
NOV 17 2008

WATER RESOURCES DEPT
SALEM, OREGON

N.E. COR
THOMAS M. REED

N.W. COR
THOMAS M. REED
D.L.C. NO. 72

S.E. COR
THOMAS M. REED
D.L.C. NO. 57

APPNO R 87338