


Township 5 South, Range 11 East, Section 36  
North West Quarter

SEE MAP JJ 11 23

scale = 1" : 400'

Center point of dam is 1340' east and 744' south of the Northwest corner of Section 36

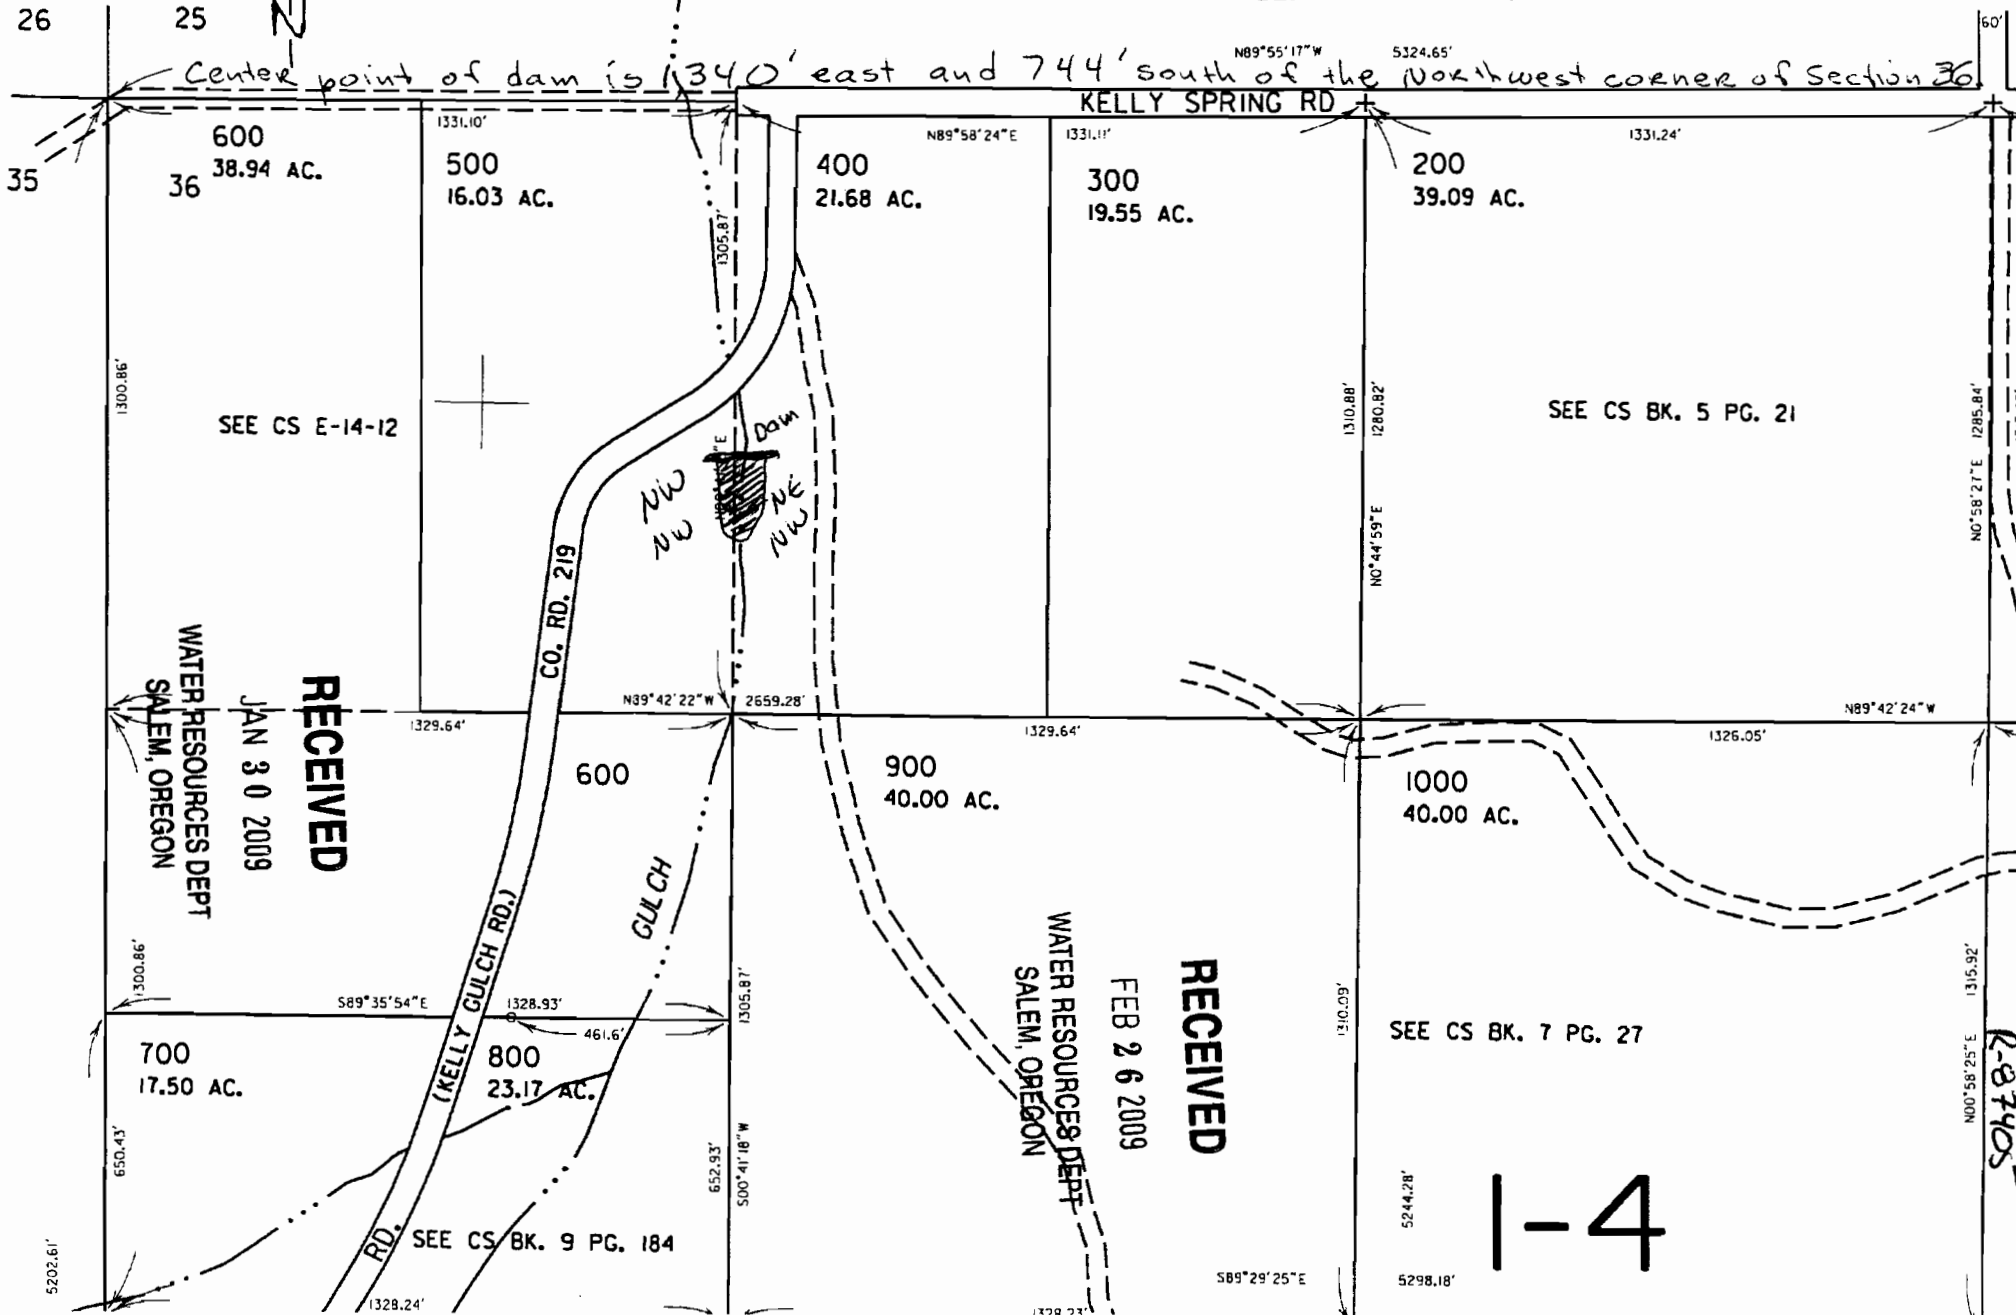

RECEIVED

JAN 30 2009

WATER RESOURCES DEPT  
SALEM, OREGON

RECEIVED

FEB 26 2009

WATER RESOURCES DEPT  
SALEM, OREGON

SEE CS BK. 5 PG. 21

SEE CS BK. 7 PG. 27

SEE CS BK. 9 PG. 184

1-4

R-87405