

18 S. 4 W.

LANE COUNTY

SCALE 1" = 300'

SEE MAP 18 04 06

7/25/78	PLAT	18-03-05	W1/4	1805
7/25/78	DATE	18-03-05	W1/4	1805

DATE: 18-03-05

C.A.D. SYS.


LCCM 18-03-05, W1/4

CANCELLED 1805

SEE MAP 18 04 05

WORK COPY

CORRECTED APPROX SCALE 1" = 300 FEET

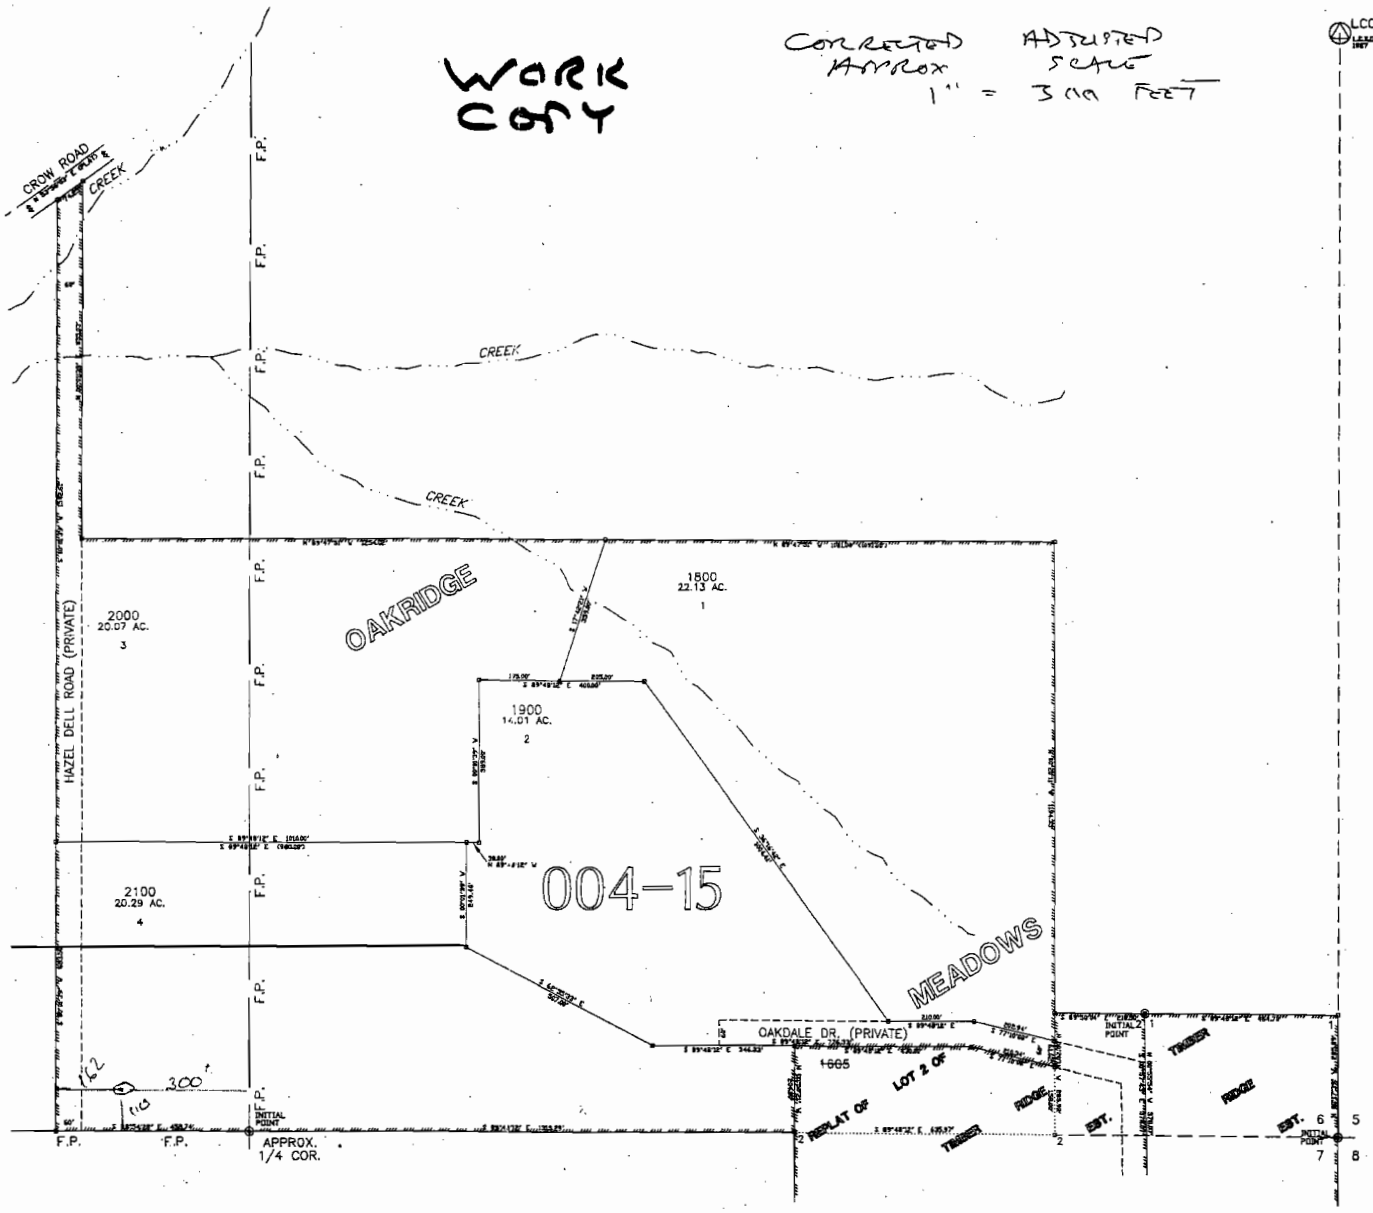

App No R 87340