


RAILROAD RAILROAD RIGHT-OF-WAY  
 STREAM, LAKE, ETC. TAX LOT BOUNDARY  
 SUBDIVISION BOUNDARY FENCIBLE PLAY BAY  
 TAX CODE BOUNDARY EASEMENT

**SYMBOL TYPES**  
 ALL RECEIVED  
 CONTROL POINT JUN 04 2009  
 SURVEY INSTRUMENT RESOURCES DEPT  
 WATER SALEM, OREGON  
 G.L.A. CORNER


**NUMBERS**  
 TAX CODE NO.  
 000 00 00 0

ACRESAGE - ALL ACRESAGES INCLUDE ANY PORTION THAT MAY LIE WITHIN THE INDICATED PUBLIC RIGHT OF WAY.  
 TICK MARKS - WHEN A TICK MARK IS INDICATED ON THE EXTENSION OF A LINE, THEN THE DIMENSION GOES TO THE TICK MARK. GENERALLY THIS IS USED WHEN DIMENSIONS GO INTO PUBLIC RIGHT OF WAY.  
 ARROWS ARE USED WITH DIMENSIONS IN AREAS OF GREATER COMPLEXITY.

**NOTICE: This map was created for Assessor's Office use ONLY.**

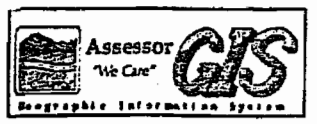

SCALE 1" = 200'  
 of 1:2400  
 Plot file created: July 30, 2009

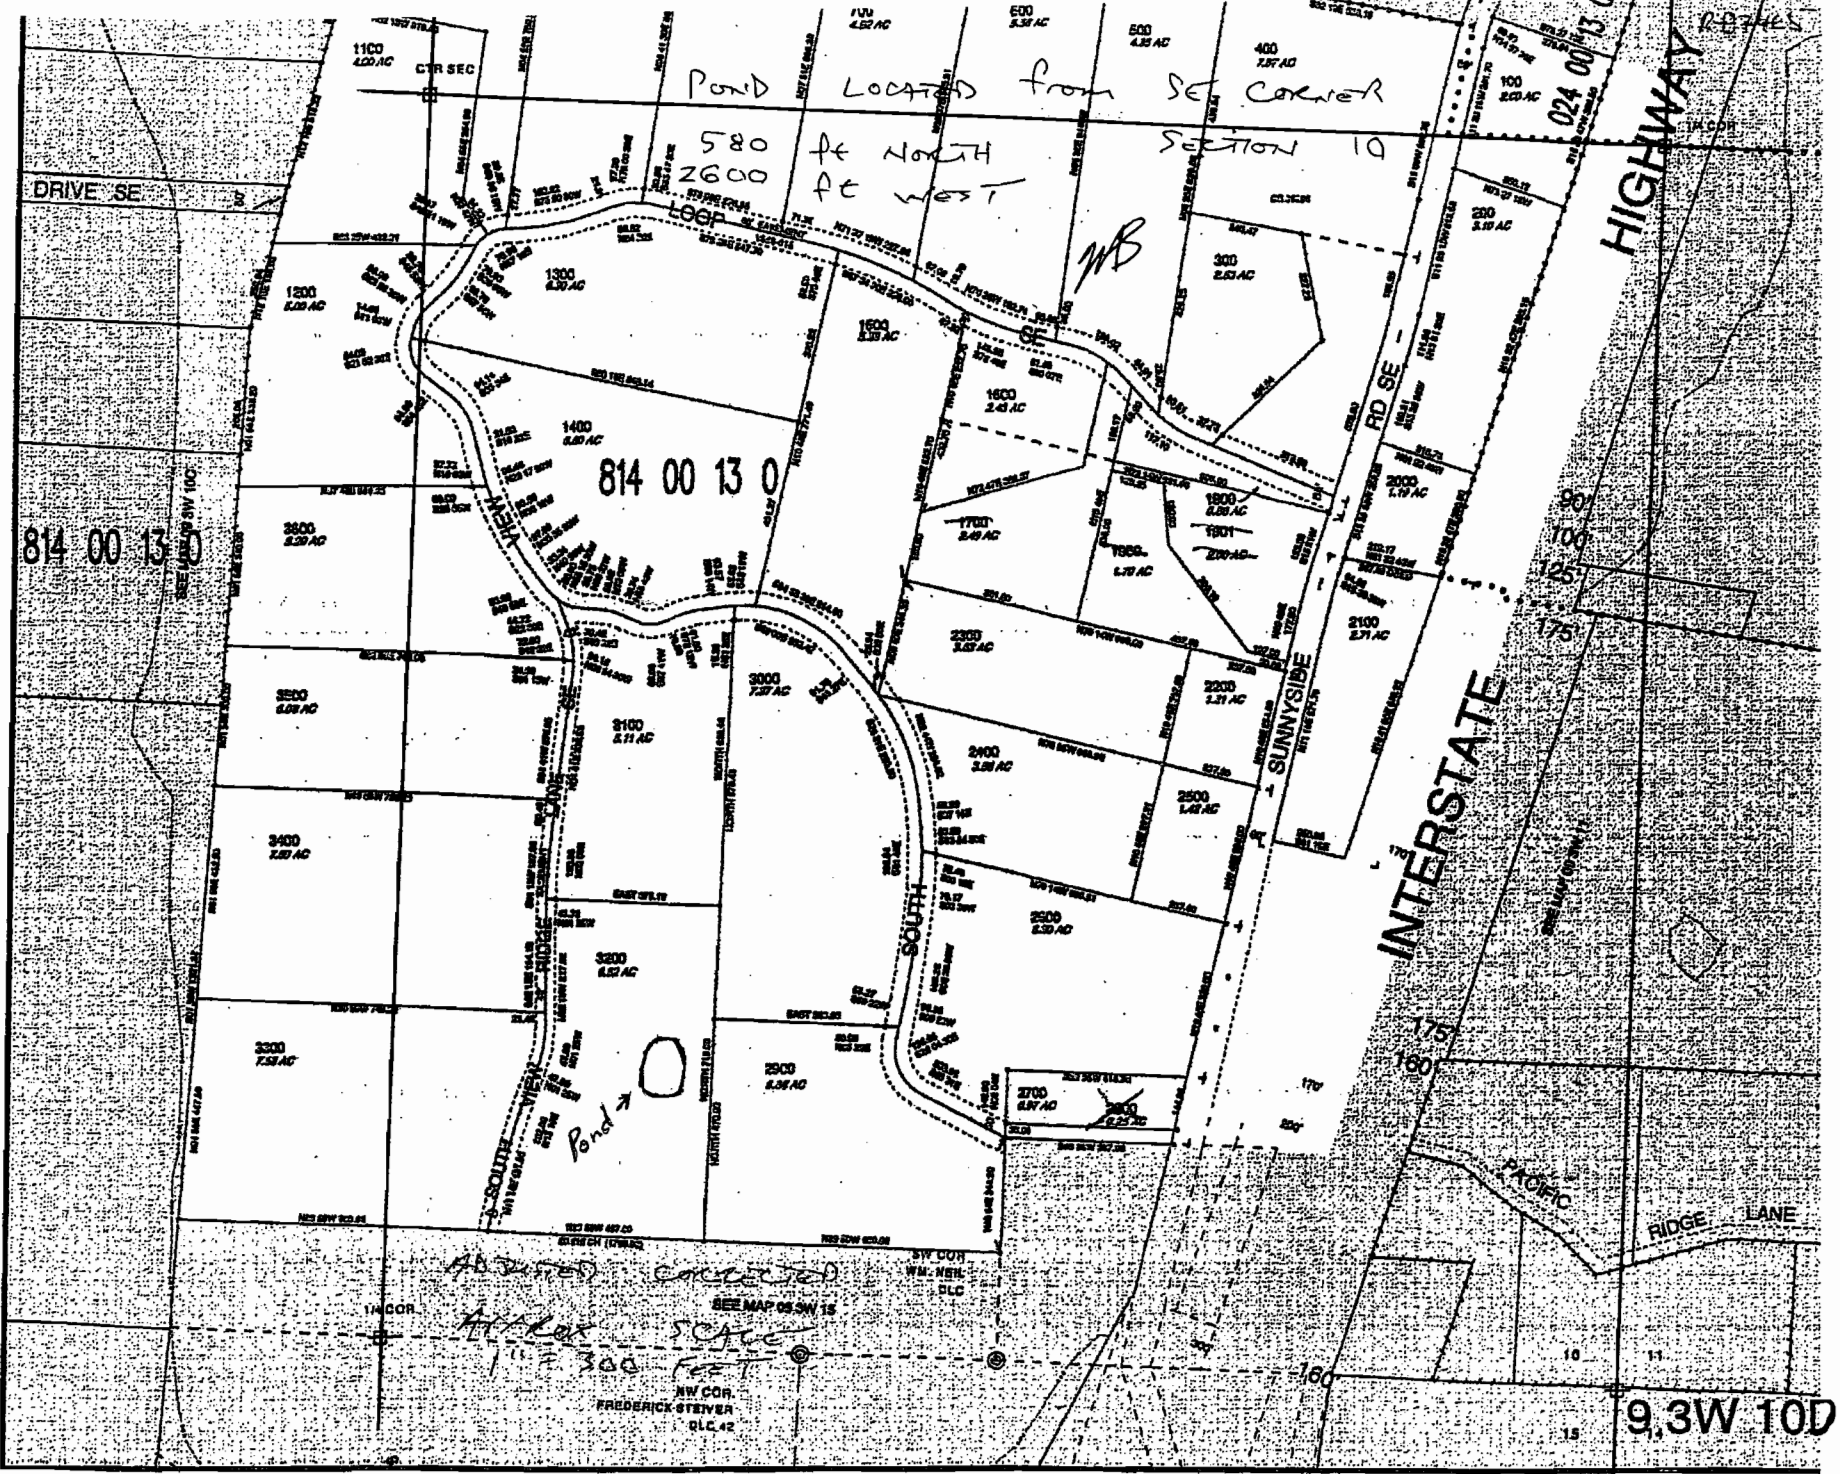

9.3W 10D