Approx ADJUSTED R-87471
Revised SCALE R1478
1" = 300 FT. 9 3W 26

SW1/4 SEC.26 T9S R3W WM, MARION COUNTY

LEGEND

LINE TYPES

TAX LOT BOUNDARY
OLD PROPERTY LINE
ROAD RIGHT-OF-WAY
VACATED RIGHT-OF-WAY
RAILROAD
RAILROAD RIGHT-OF-WAY
STREAM, LAKE, ETC. TAX LOT BOUNDARY
STREAM, LAKE, ETC. NON-BOUNDARY
SUBDIVISION BOUNDARY
PARTITION PLAT BDY.
TAX CODE BOUNDARY
EASEMENT

SYMBOL TYPES

D.L.C.
CONTROL POINTS
SURVEY MONUMENTS
G.L.O. CORNERS
SECTION
1/4 SEC
1/16 SEC

NUMBERS

TAX CODE NO.

000 00 00 0

ACREAGE – ALL ACREAGES EXCLUDE ANY PORTION THAT MAY LIE WITHIN THE INDICATED PUBLIC RIGHT OF WAYS.

TICK MARKS – WHEN A TICK MARK IS INDICATED ON THE EXTENSION OF A LINE, THEN THE DIMENSION GOES TO THE TICK MARK. GENERALLY THIS IS USED WHEN DIMENSIONS GO INTO PUBLIC RIGHT OF WAYS.

225.00
168.00

ARROWS ARE USED WITH DIMENSIONS IN AREAS OF GREATER COMPLEXITY.

NOTICE: This map was created for Assessor's Office use ONLY.

Assessor "We Care" GIS

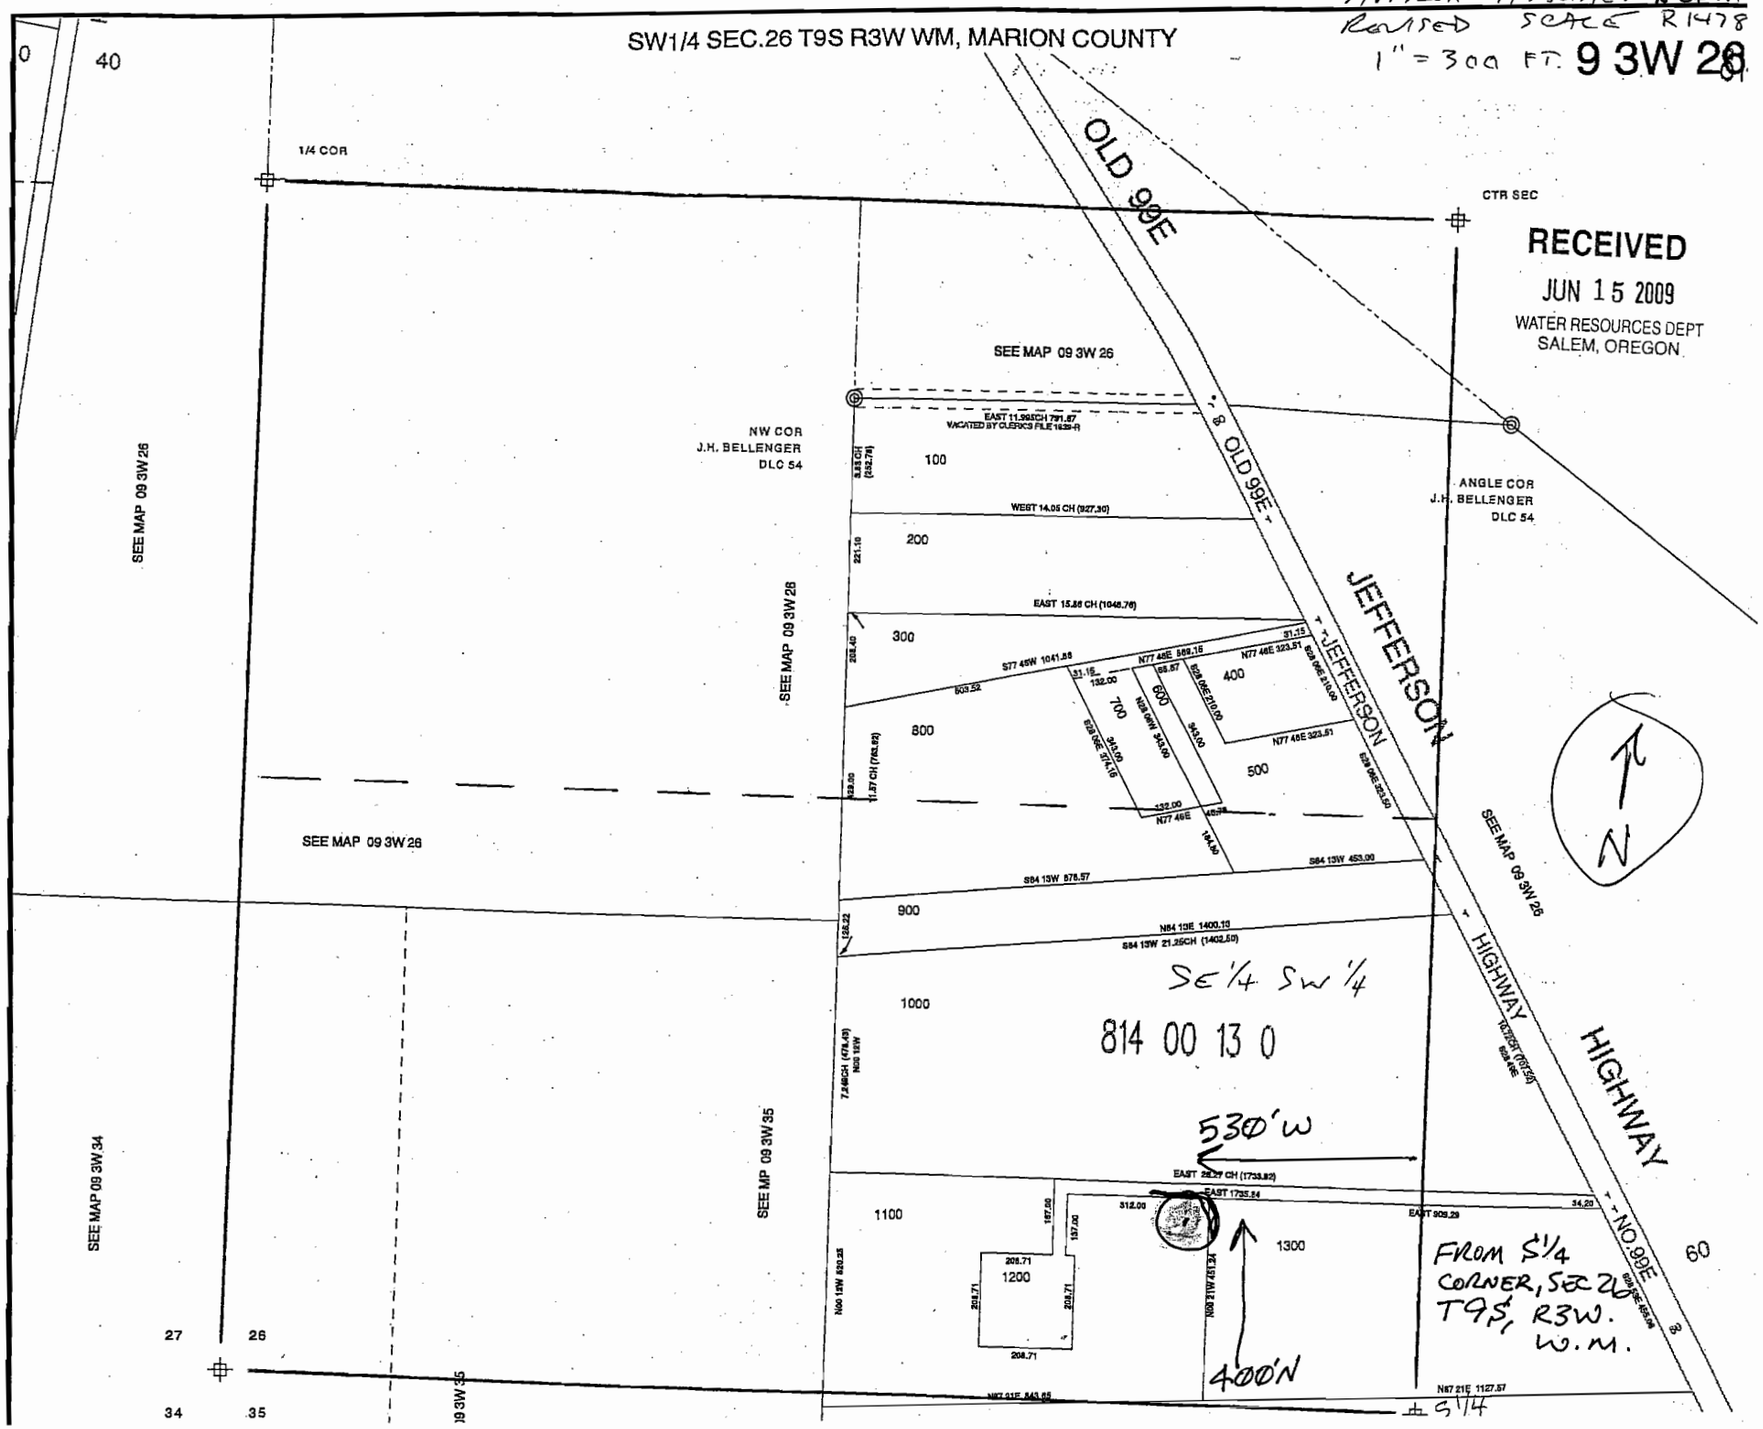

RECEIVED
JUN 15 2009
WATER RESOURCES DEPT
SALEM, OREGON