

38-2-19

Mainwaring Property
38S 2W 31 200


RESERVOIR LOCATED
CENTER SECTION 31
1750 ft SOUTH
830 ft WEST

Section
31

WOODRAT MTN



Scale
1" = 1000'

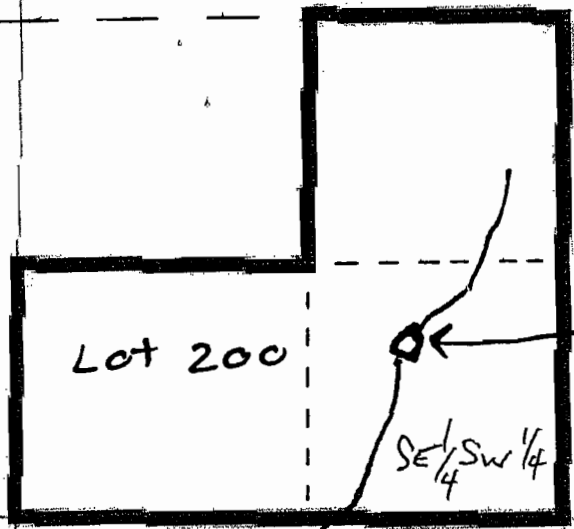

Water storage
Reservoir

Lot 200

SE 1/4 SW 1/4

SPENCER CULCH

- Map Ma
Applica
Front Counter I
- Highlighted
 - Tax Lot Out
 - City Limits
 - Ashland
 - Butte Falls
 - Central Point
 - Eagle Point
 - Gold Hill
 - Jacksonville
 - Medford
 - Phoenix
 - Rogue River
 - Shady Cove
 - Talent

RECEIVED

AUG 14
WATER RESOURCE
SALEM, ORE

