

MAP OF EXISTING POND


LOCATED IN THE N.W. 1/4 OF THE S.W. 1/4,
SECTION 22, T. 36 S., R. 6 W., W.M.,
JOSEPHINE COUNTY, OREGON

N. 1/16 COR.

LEONARD ROAD

ROAD

WESTWOOD DRIVE

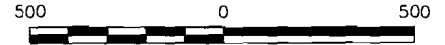


SCALE: 1" = 500'

ROAD

BOUNDARY

W. 1/4 COR.

C. 1/4 COR.

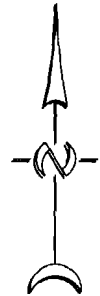

NW 1/4, SW 1/4

819'

536'

EXISTING POND

OJAI AVENUE

T.L. 801

AVENUE

REDWOOD

LEGEND

● FOUND MONUMENT

BASIS OF BEARINGS
PER C.S. 88-2000

TAX MAP: 36-06-22-CO
TAX LOT: 801

DATE: MAY 15, 2009

RECEIVED

MAY 29 2009

WATER RESOURCES DEPT
SALEM, OREGON

PREPARED FOR:

BRYAN HALL
P.O. BOX 5037
GRANTS PASS, OR

PREPARED BY:

MAX H. HULL SURVEYING
231 N.W. "B" STREET
GRANTS PASS, OR

21 22

28 27

SECTION COR.