


MAP OF EXISTING PONDS

LOCATED IN THE WEST HALF OF
SECTION 22, T. 36 S., R. 6 W., W.M.,
JOSEPHINE COUNTY, OREGON

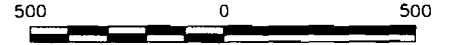

SCALE: 1" = 500'



N. 1/16 COR.

LEONARD ROAD

ROAD

WESTWOOD DRIVE

T.L. 1202

SW 1/4, NW 1/4

SAND

CREEK

81'

EXISTING POND

772'

W. 1/4 COR.

C. 1/4 COR.

ROAD

BOUNDARY

NW 1/4, SW 1/4

819'

EXISTING POND

AVENUE

0.141

T.L. 801

536'

AVENUE

REDWOOD

21 22

28 27

SECTION COR.

LEGEND

● FOUND MONUMENT

BASIS OF BEARINGS
PER C.S. 88-2000

TAX MAP: 36-06-22-B0
TAX LOT: 1202

TAX MAP: 36-06-22-C0
TAX LOT: 801

DATE: MAY 15, 2009

RECEIVED

MAY 29 2009

WATER RESOURCES DEPT
SALEM, OREGON

PREPARED FOR:

BRYAN HALL
P.O. BOX 5037
GRANTS PASS, OR.

PREPARED BY:

MAX H. HULL SURVEYING
231 N.W. "B" STREET
GRANTS PASS, OR.