

3595' DEED
3381.70' CALC.
2655.15'

30

29

202

R-27457

180

200

213

214

773


704

707

800

901

1000

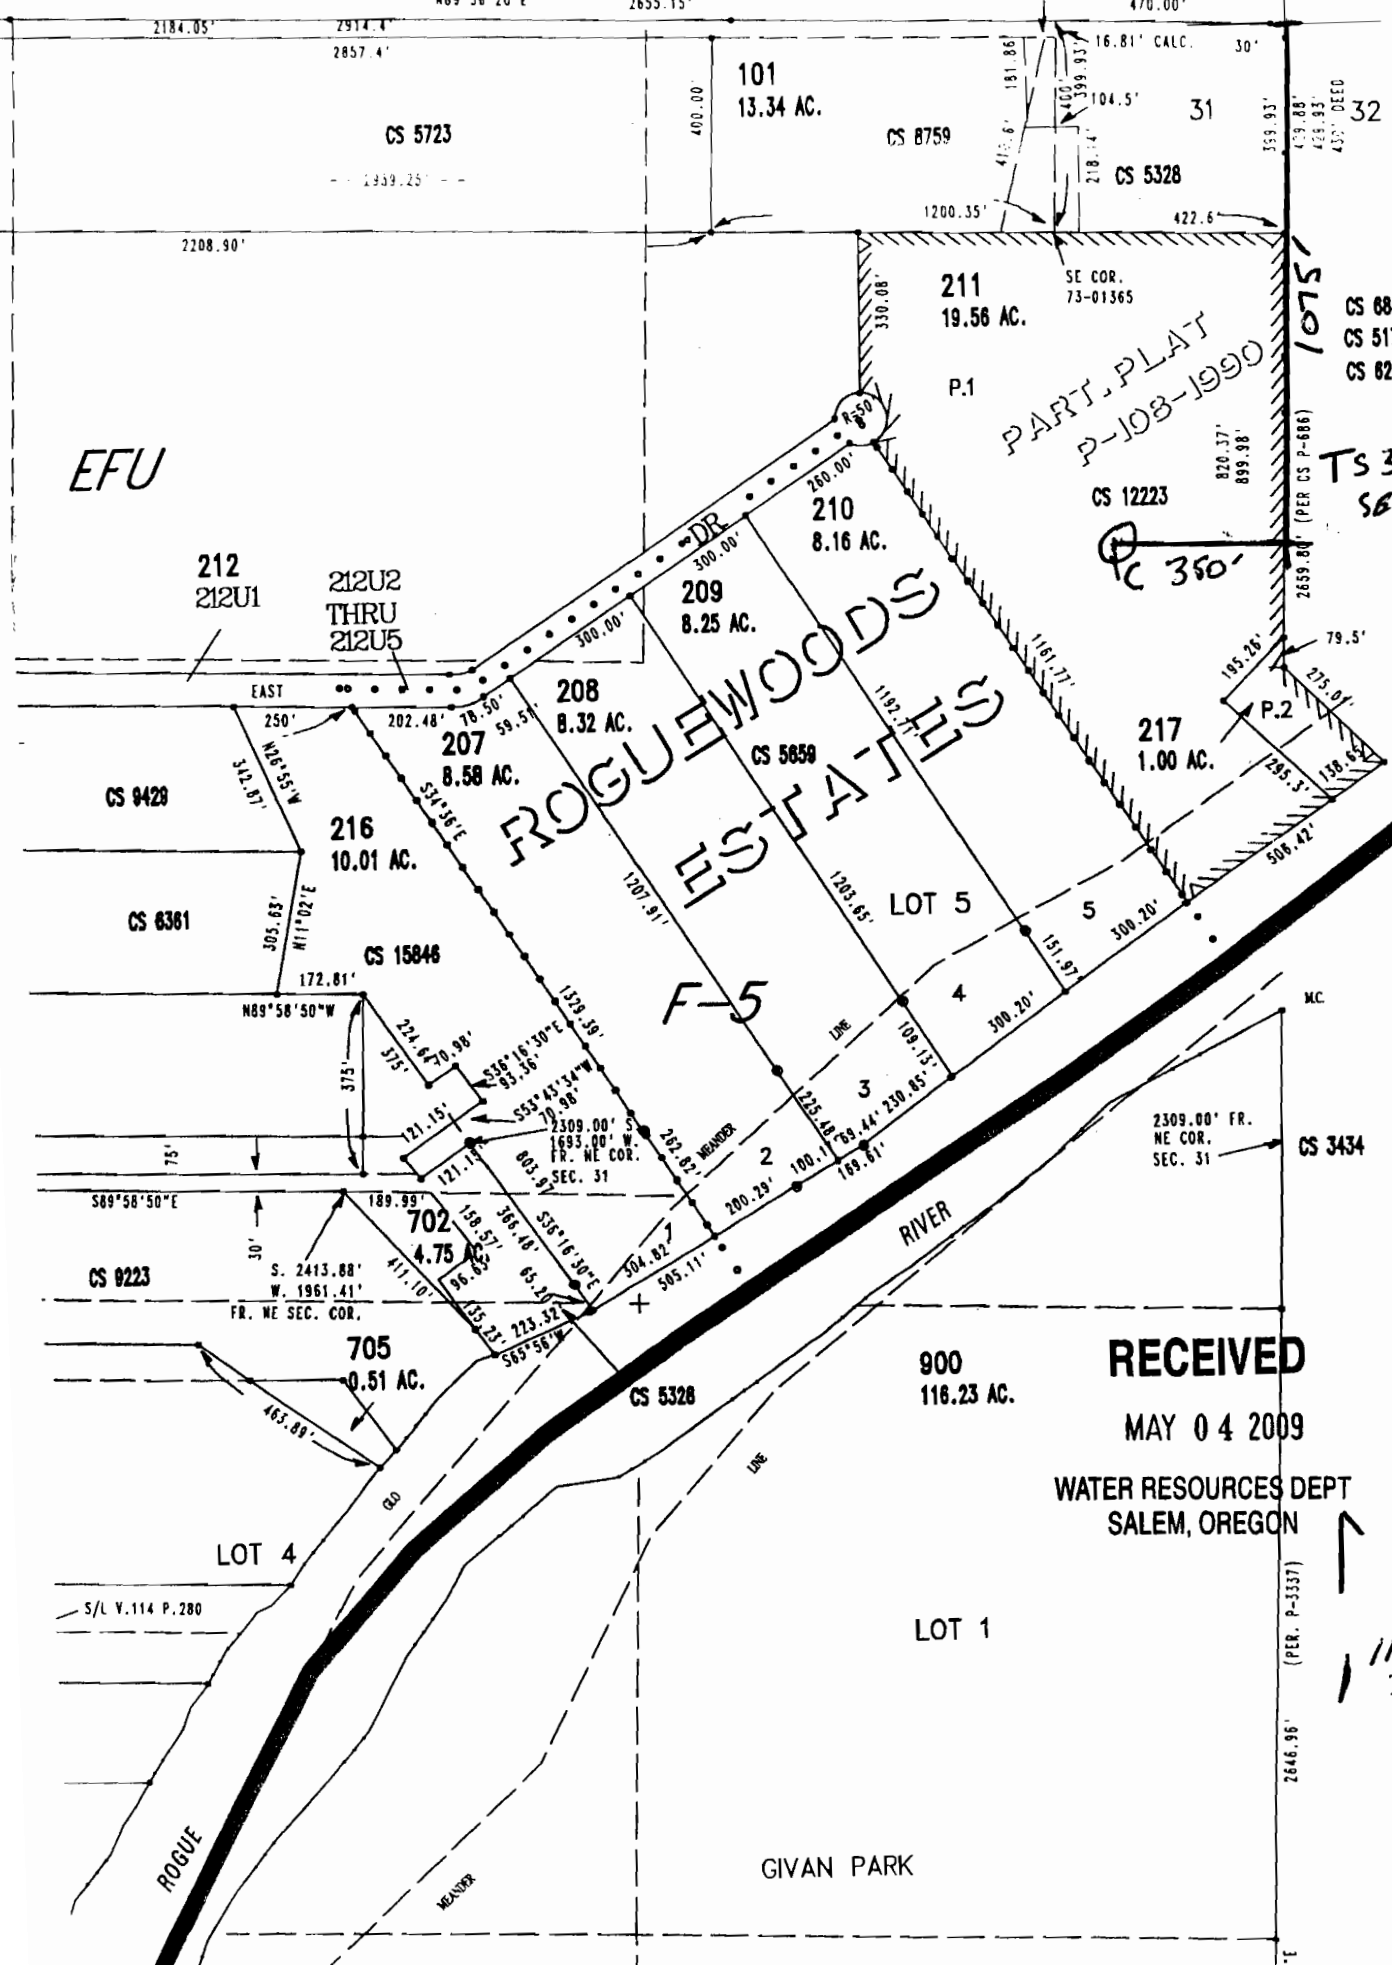

EFU

PART. PLAT
P-108-1990

TS 35 S R 1 W
SEC 31
TL 211
46/46

PC 350'

RECEIVED

MAY 04 2009

WATER RESOURCES DEPT
SALEM, OREGON

SEE MAP 35 1W 6

N

1" = 400'

GIVAN PARK