


R-07474

WORK COPY

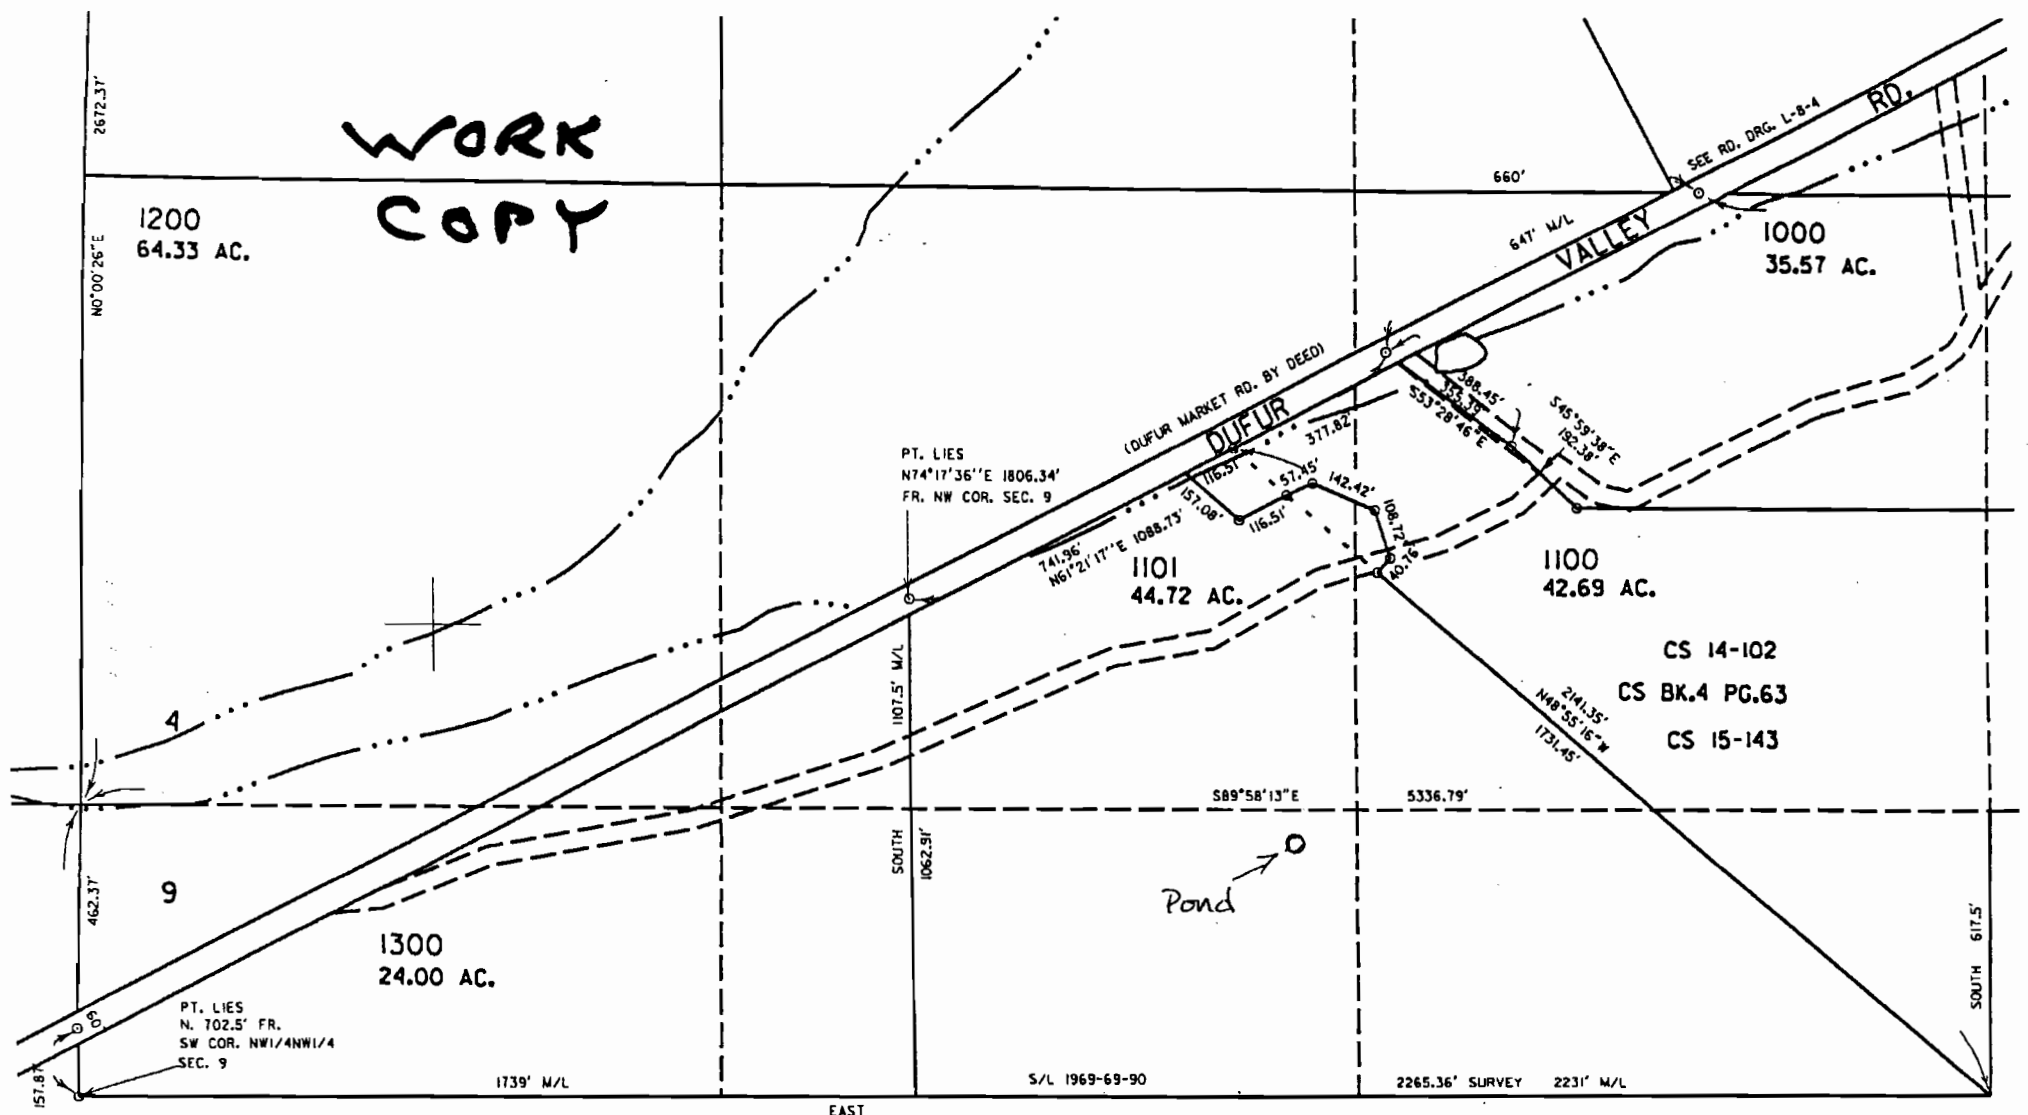

1,791,000

2S-12E-4E9

Pond 2520' E / 60' S of NW corner of Sec. 9



SEE MAP 2S 12

WATER RESOURCES DEPT
SALEM, OREGON

JUN 18 2009

RECEIVED

SCALE
1" = 400'