


SEE MAP 38 5

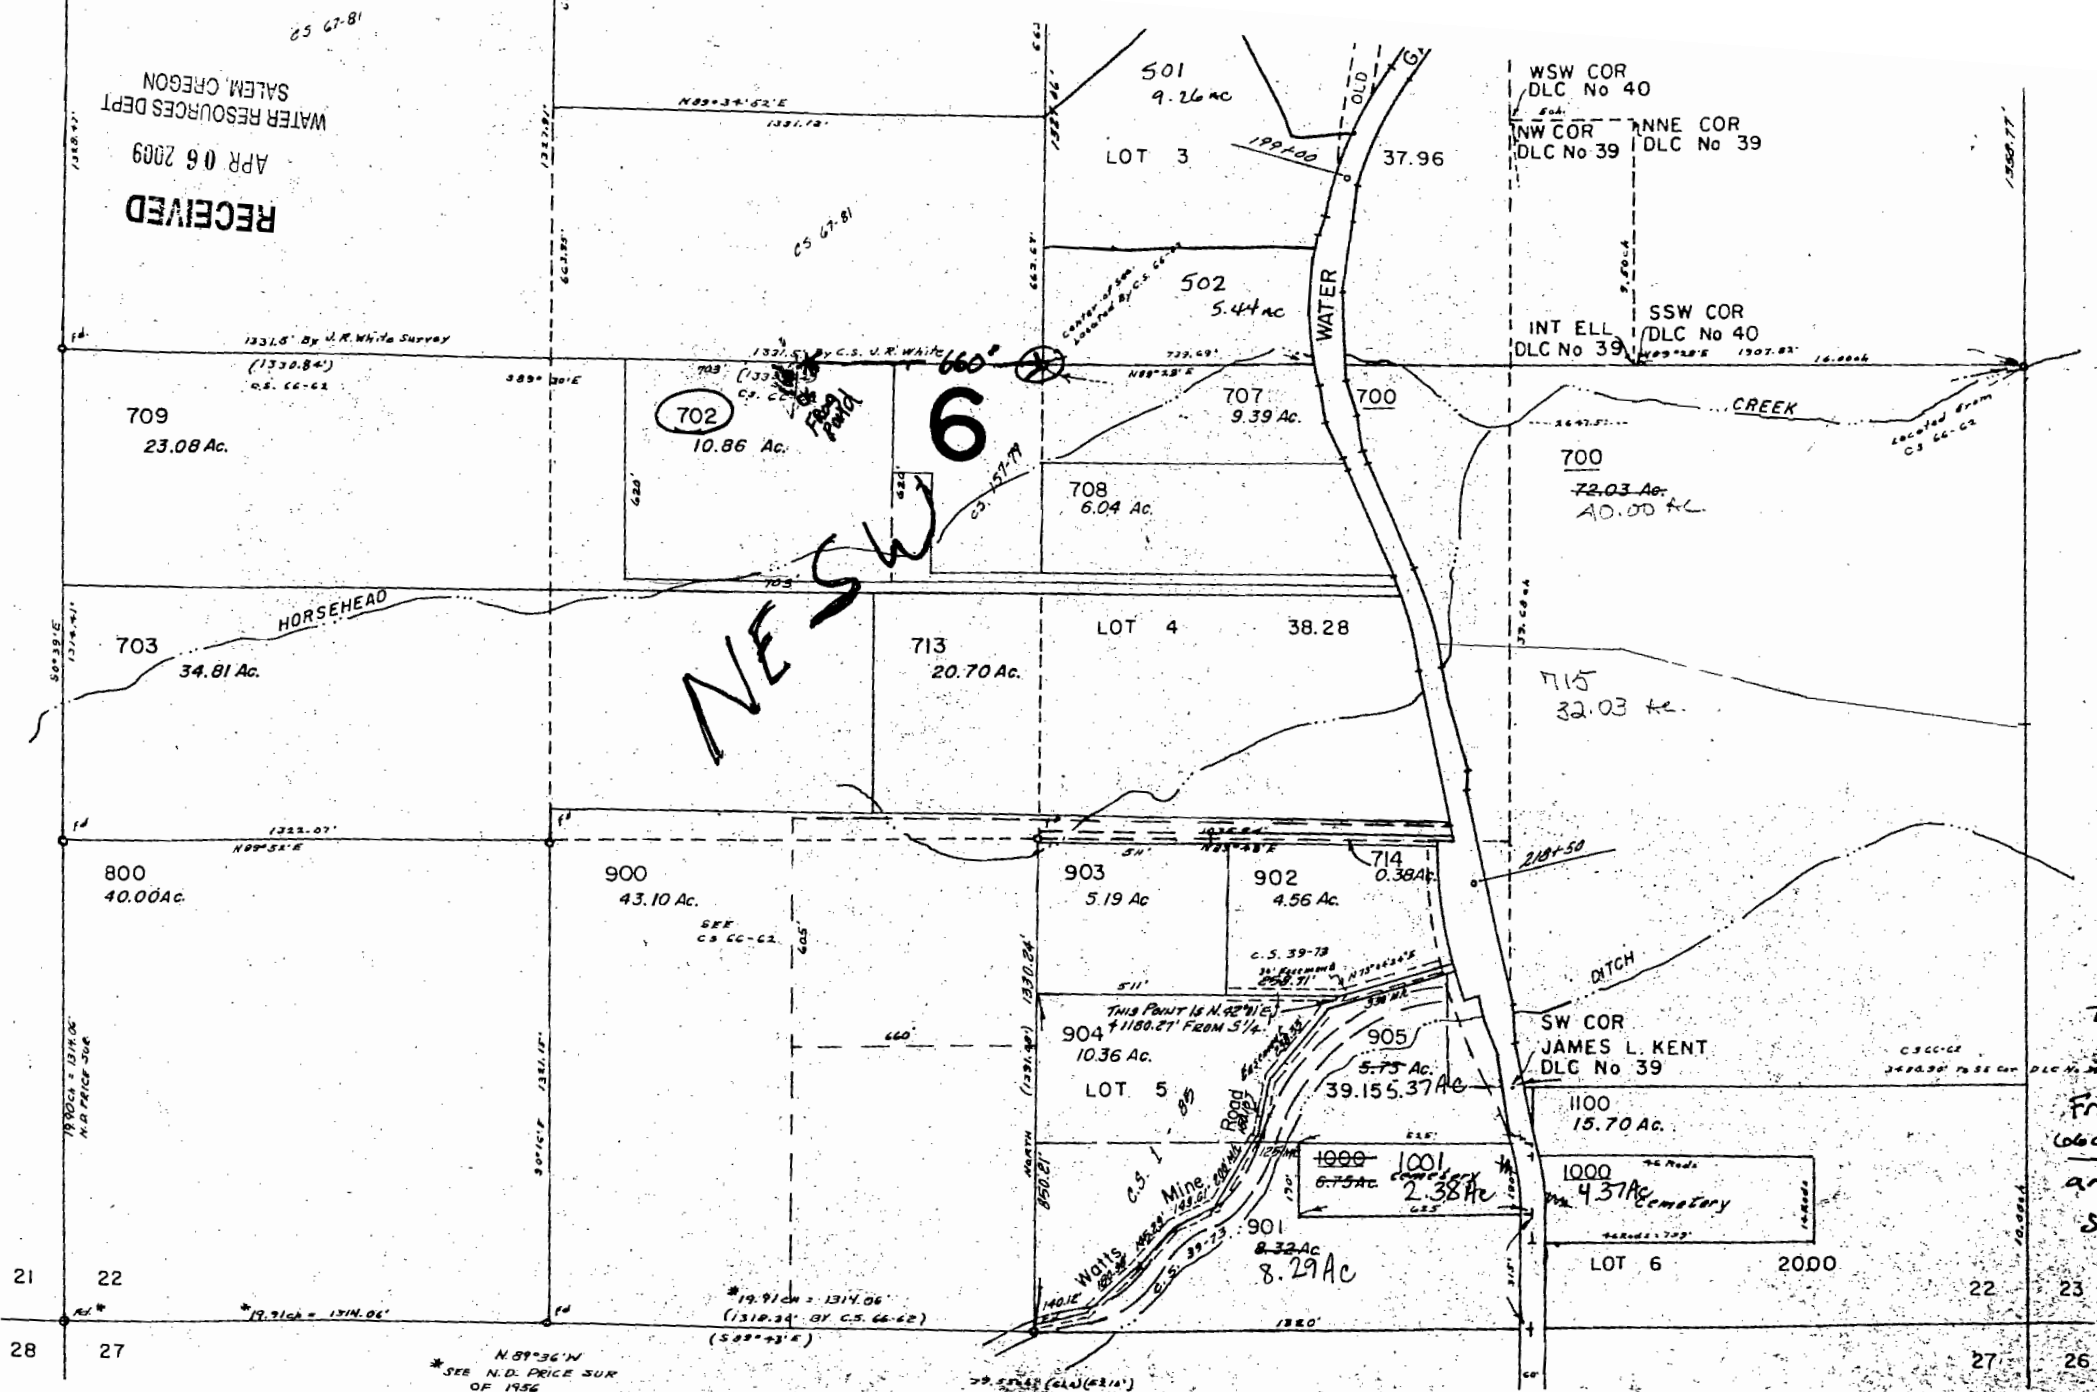

RECEIVED
 APR 06 2009
 WATER RESOURCES DEPT
 SALEM, OREGON

NE SW
 6

R07455

SEE MAP 38 5 23



SCALE
 1" = 400'
 T38S
 R5W
 Sec 22
 Parcel 702

Frag pond is
 660 feet west
 and 100 feet
 south from
 center of

T38S
 R5W
 Sec 22

N 89° 34' W
 * SEE N.D. PRICE SUR
 OF 1956

SEE MAP 38 5 27

38 5 22