
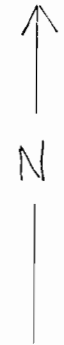


Scale 1" = 400'

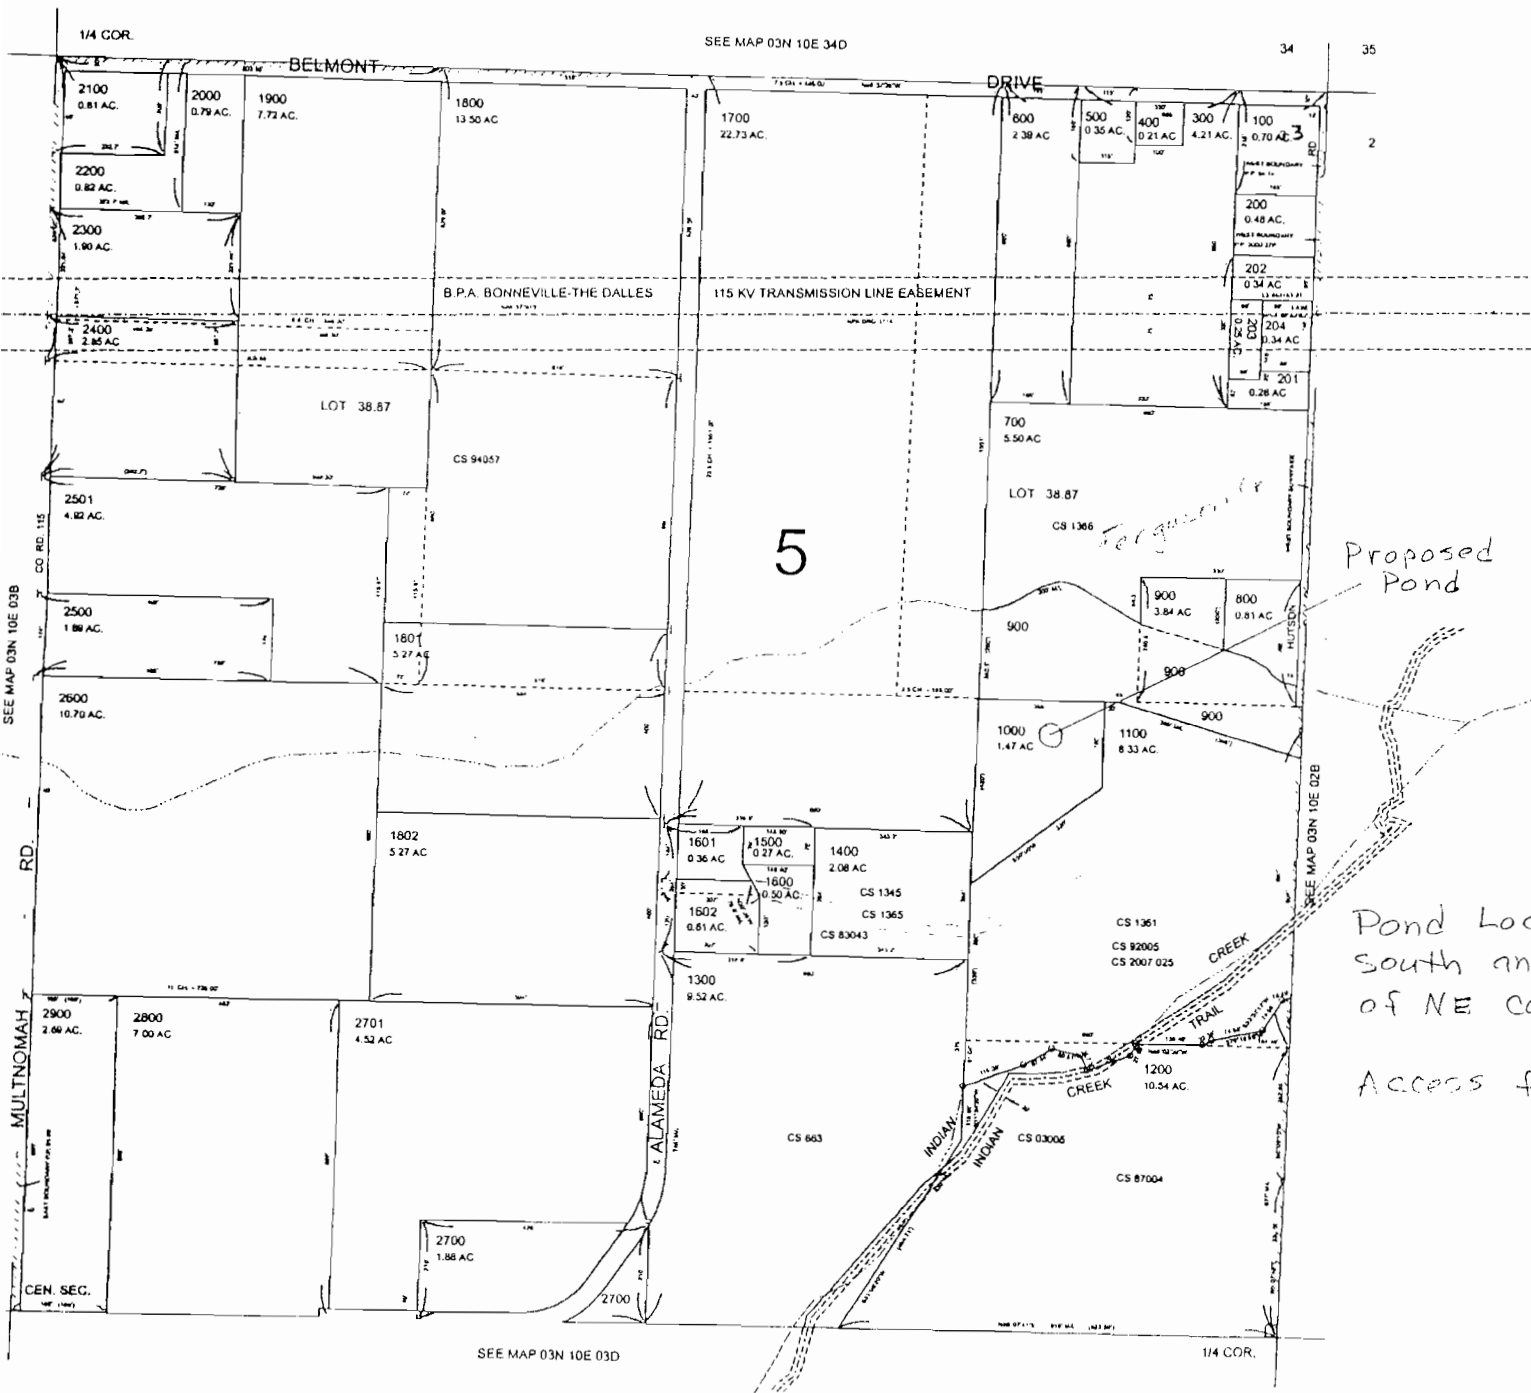

RECEIVED

JUL 20 2009

WATER RESOURCES DEPT
SALEM, OREGON

Pond Located 1350 Feet
South and 525 Feet West
of NE Corner of section 3.

Access from Alameda Road