


O MOUNTAINAIR, LTD

T 38 S, R 18 E  
SECTION 32

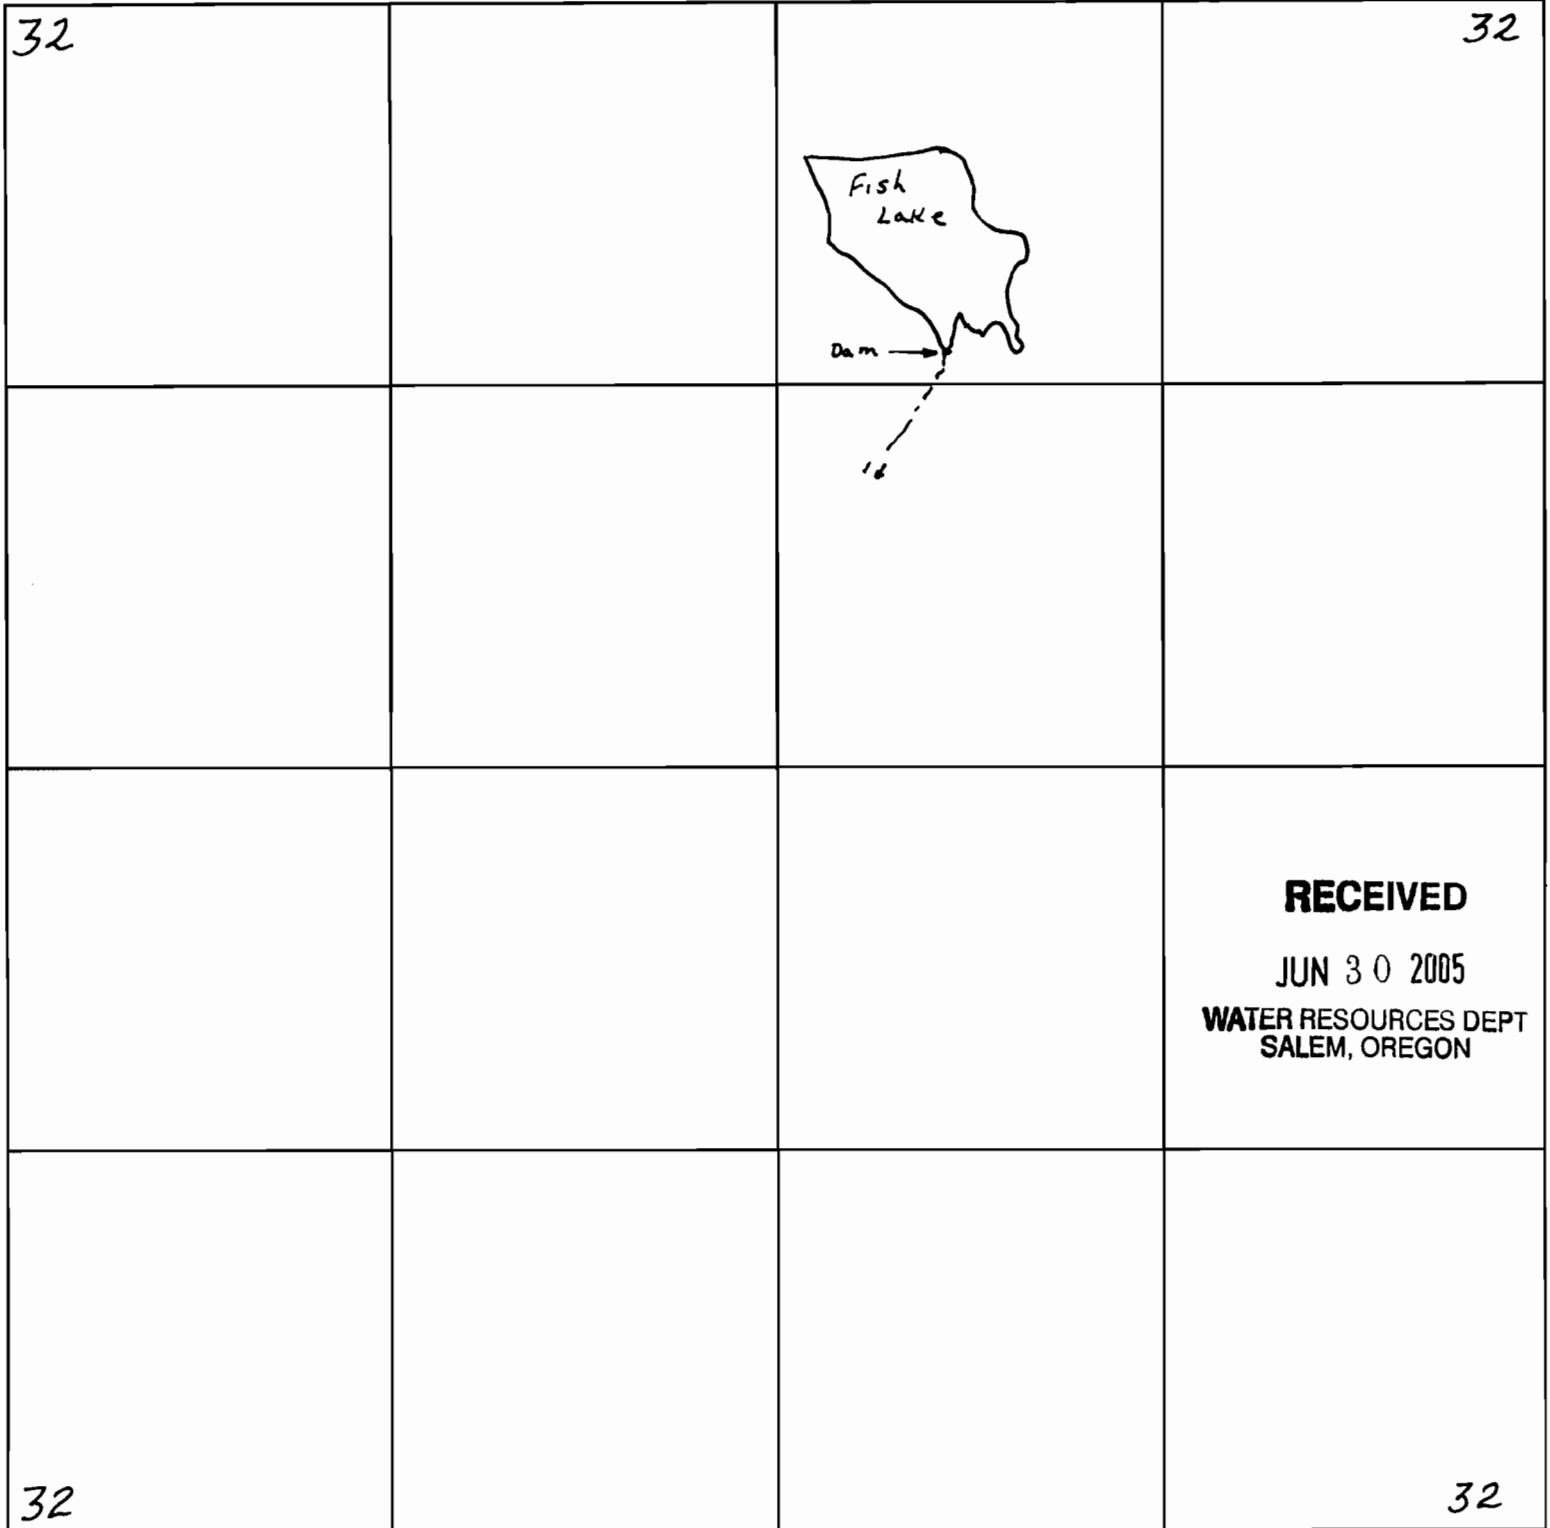

Dam located 1200' South and 2050' West from the NE Corner, Section 32.



Scale 8" = 1 mile

appno R-86357