


T8N R8W SEC 26 WM
CLATSOP COUNTY

Scale 1:4800

 


NAD 1983/91 HARN StatePlane Oregon North FIPS 3601 Int'l Feet

Additional Detail Maps on Separate Sheets

Cancelled
Accounts

- 1600
- 182
- 189
- 1100
- 1102
- 1103
- 1104
- 1204
- 1550
- 200
- 2000
- 2002
- 2003
- 2004
- 2005
- 2102
- 2200
- 2301
- 2400
- 2500
- 2501
- 2600
- 2601
- 2602
- 2700
- 2800
- 2801
- 2802
- 2803
- 2804
- 2805
- 2900
- 2901
- 2902
- 3000
- 301
- 302
- 3100
- 3101
- 3200
- 3300
- 3301A1
- 3301
- 800
- 990

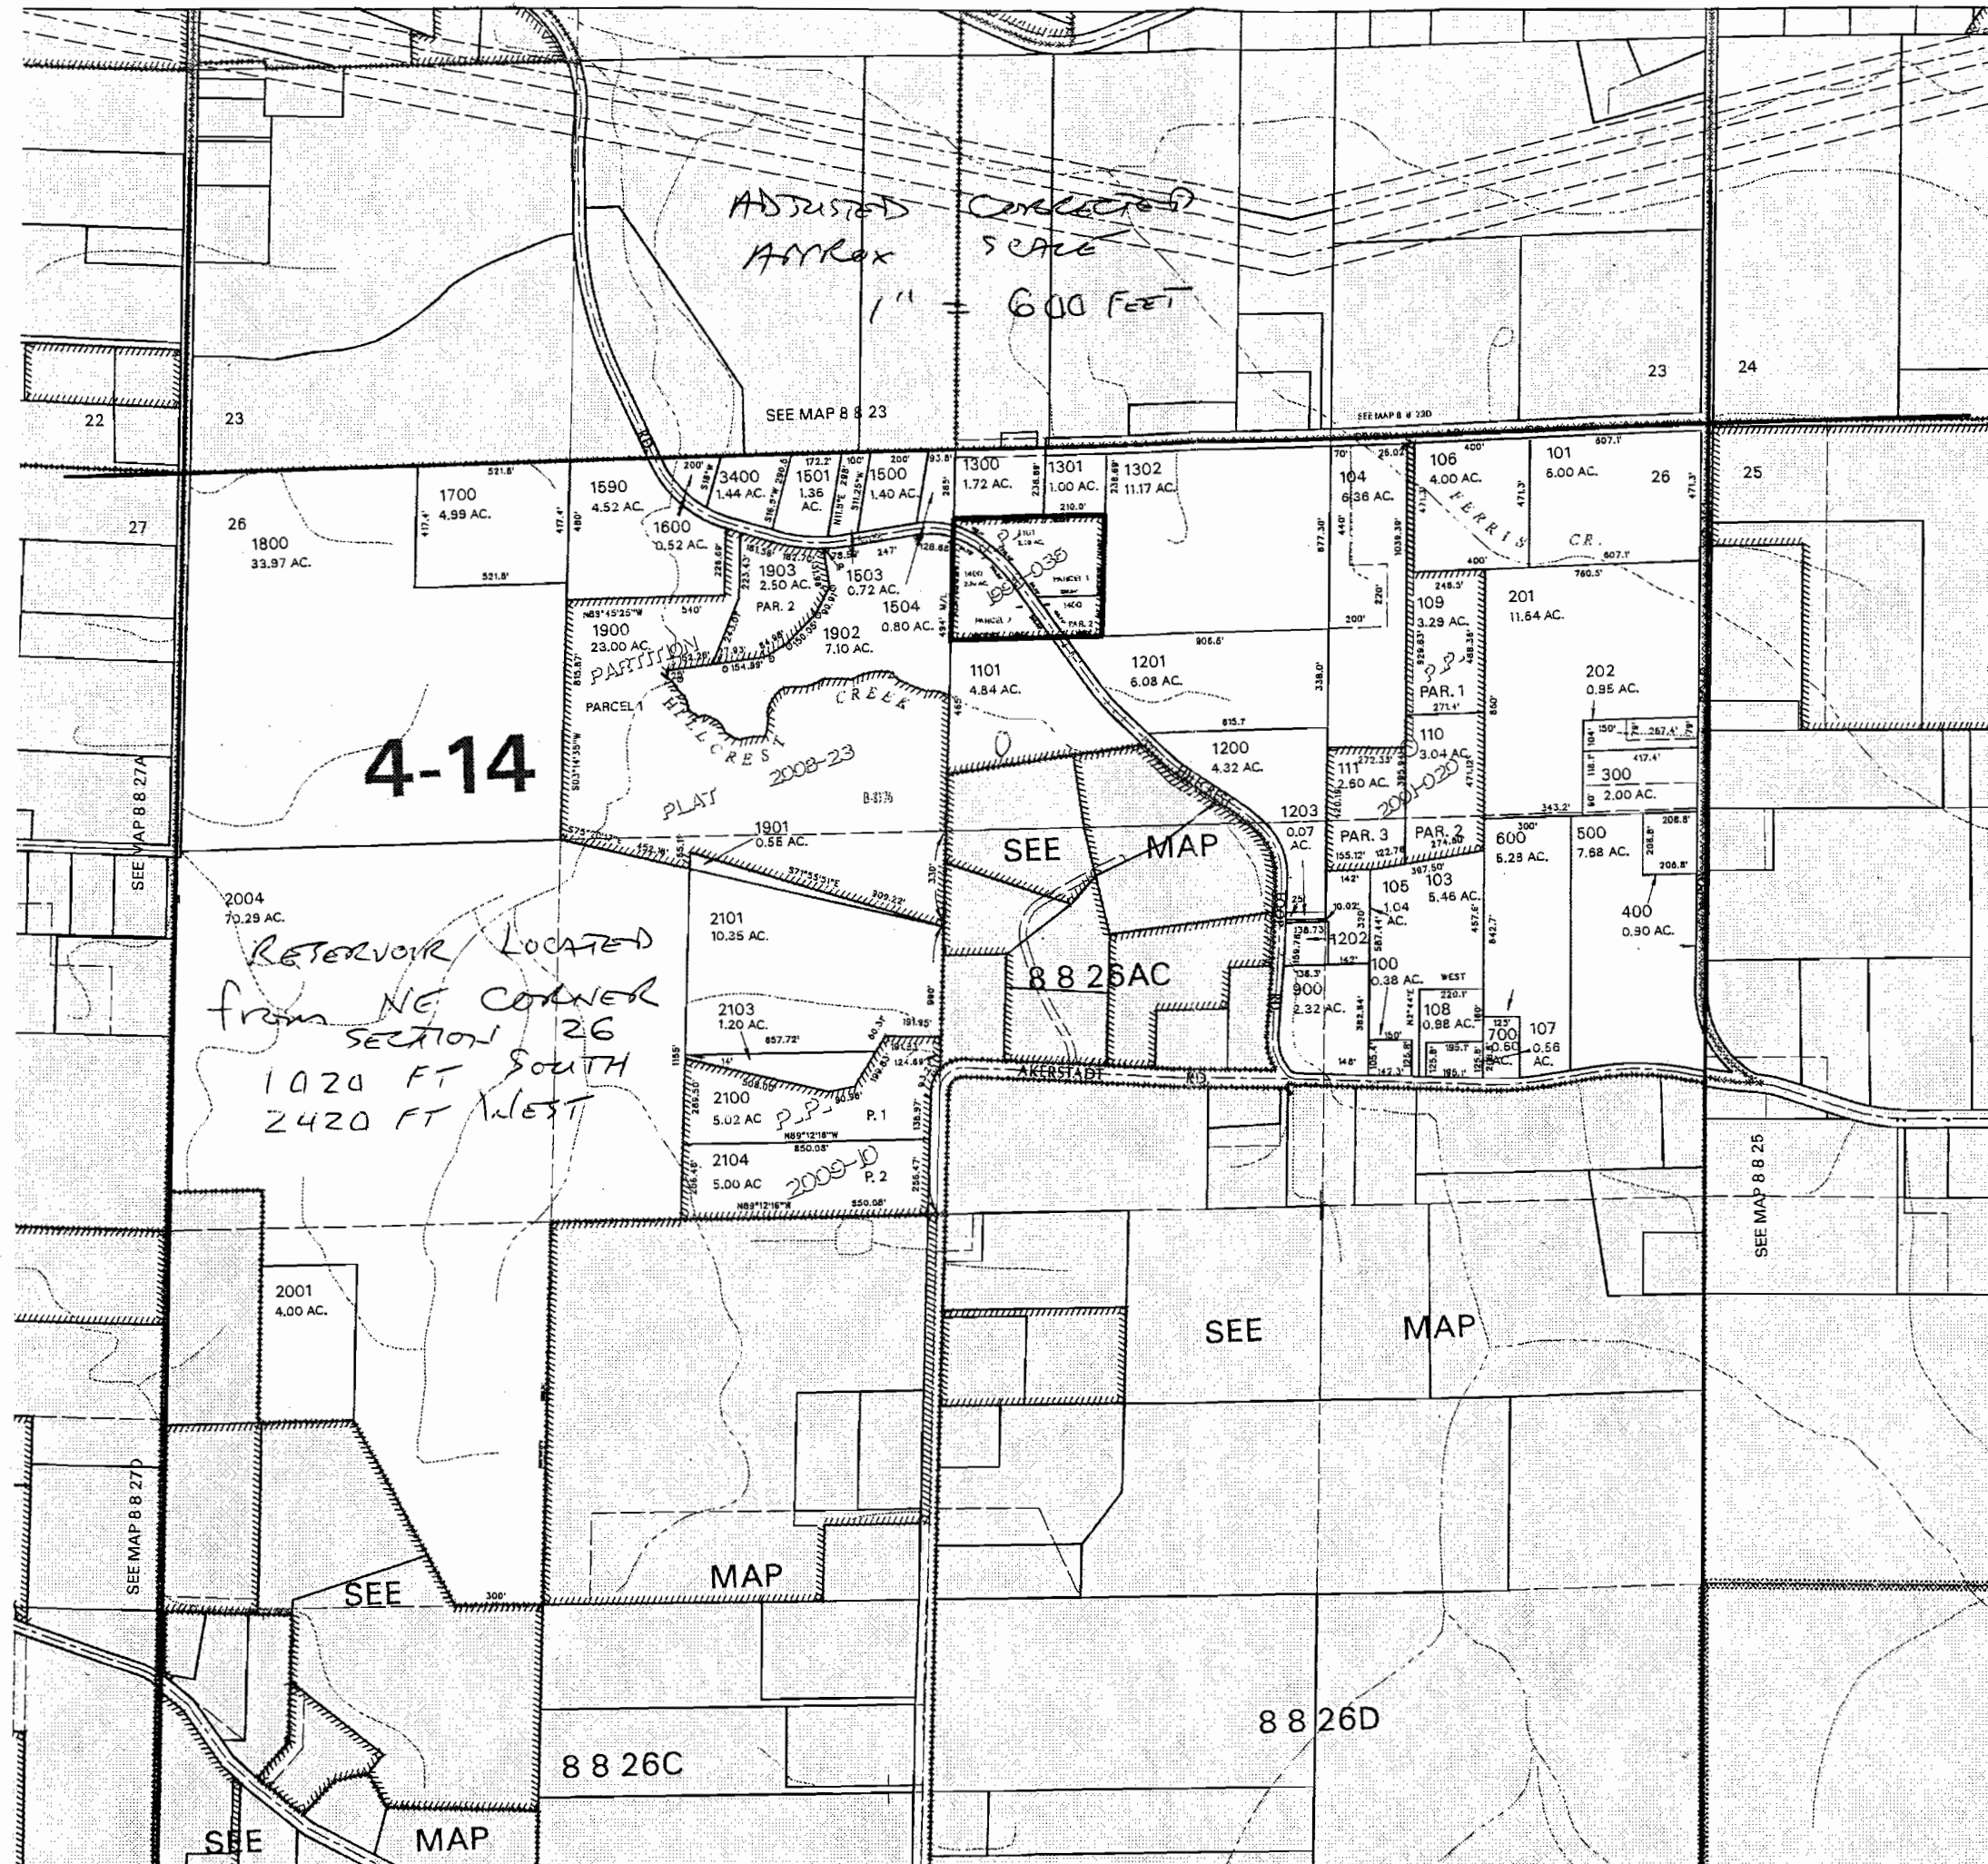

4-14

RESERVOIR LOCATED
FROM NE CORNER
SECTION 26
1020 FT SOUTH
2420 FT WEST

							31
1	6	5	4	3	2	1	6
12	7	8	9	10	11	12	7
13	18	17	16	15	14	13	18
24	19	20	21	22	23	24	19
25	30	29	28	27	26	25	30
36	37	32	33	34	35	36	31
1	6	5	4	3	2	1	6



R-87574