

BOOK 2
App No R87267

THE OLD POND #1
THE OLD POND #2


SEP 18 2008
WATER RESOURCES DEPT
SALEM, OREGON

SECTION 33 T.34S. R.6W. W. 1
JOSEPHINE COUNTY

SCALE 1" = 400'

MAP FOR POND 1

SEE MAP 34 6 28

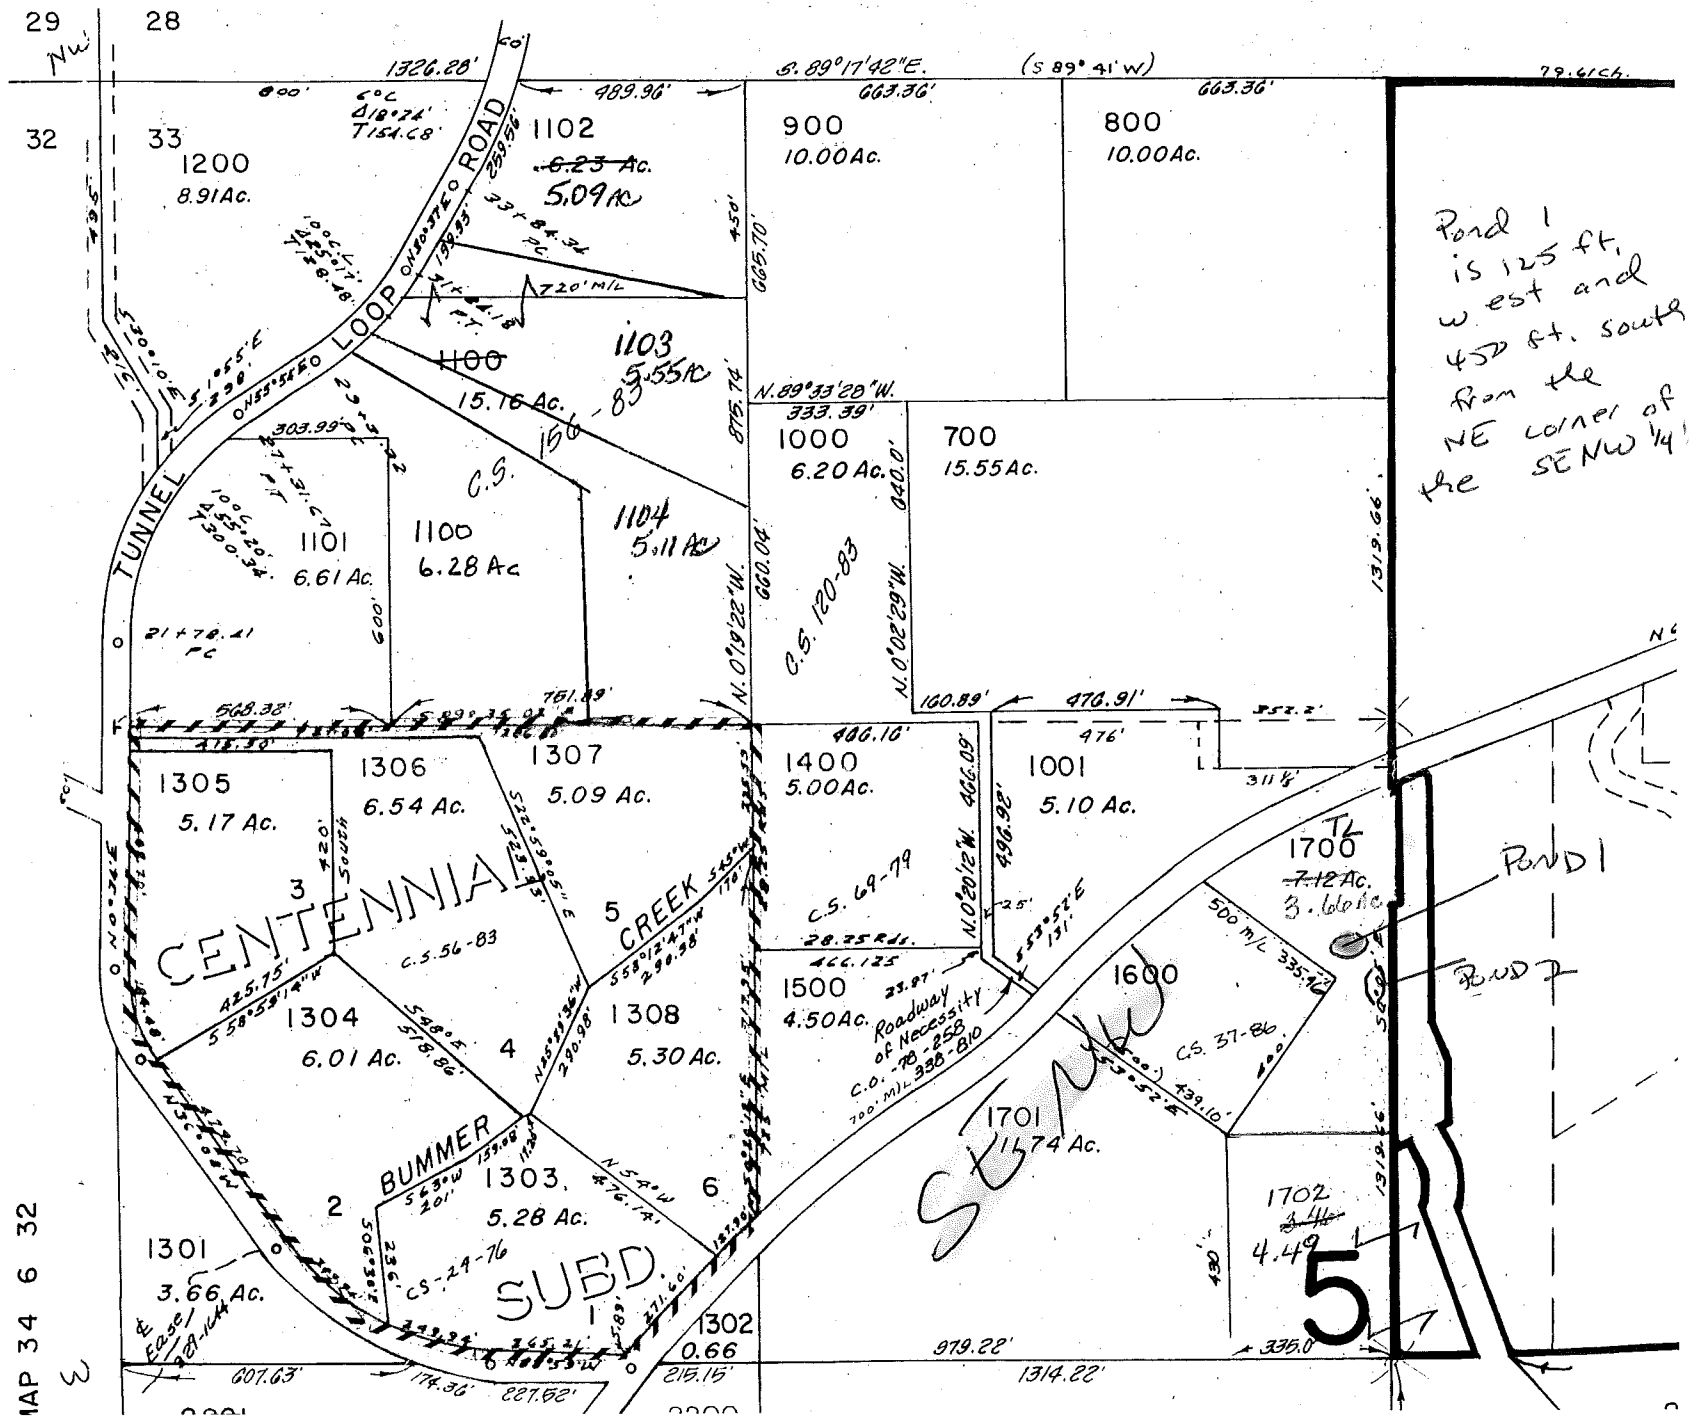

N
↑

RECEIVED

AUG 25 2008

WATER RESOURCES DEPT
SALEM, OREGON

MAP 34 6 32