


SEC. 15 T. 12S. R. 01 W

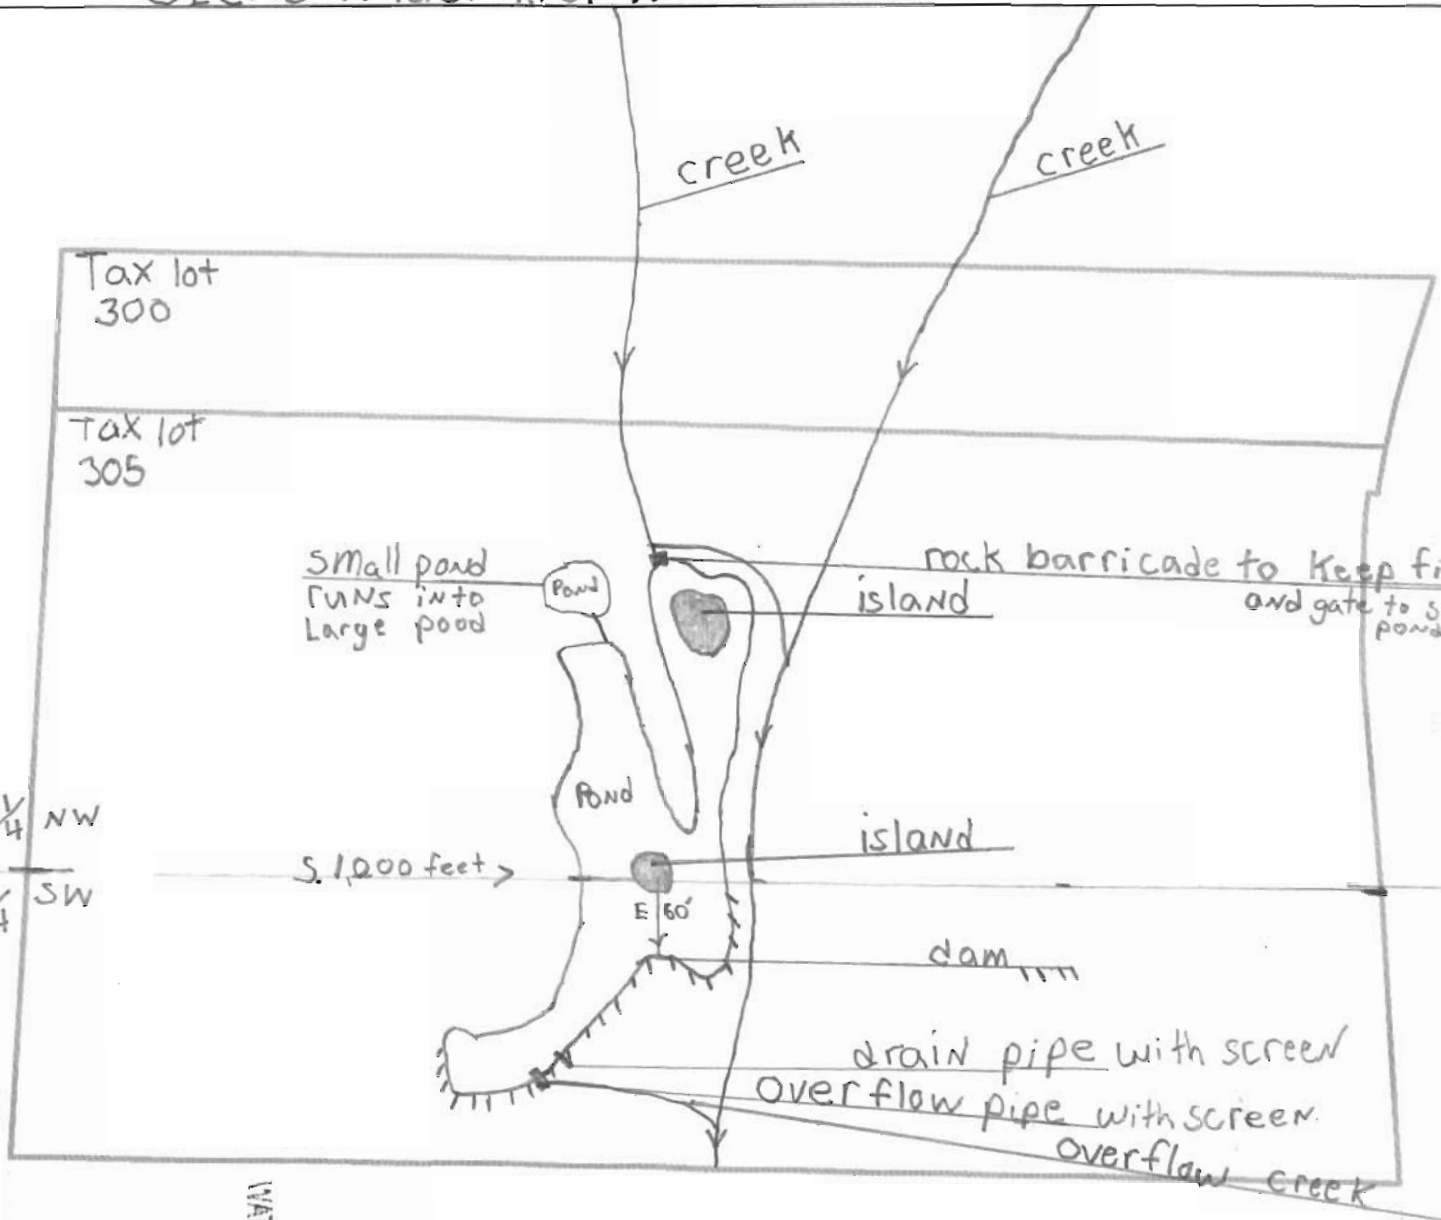

1/4 NW
1/4 SW
1/4
1/4

S. 1,200 feet

E 60'

Dam 1,000 feet south
and 60 feet east of
1/4 1/4 SEC 15

RECEIVED
MAY 06 2010
WATER RESOURCES DEPT
SALEM OREGON

4978-2

N
1 inch = 200 feet

Linn County
GIS Department
P.O. Box 100
Albany, OR 97321




Linn County Disclaimer
This product is for informational purposes only and may not have been prepared for, or be suitable for legal, engineering, or surveying purposes. Users of this information should review or consult the primary data and information sources to ascertain the reliability of this information.

MAP WAS PREPARED FOR
ASBESTOS PURPOSES ONLY

SEC. 15 T. 12S. R. 01W. W.M.
LINN COUNTY, OREGON

1" = 400'

SEE MAP 12 1W 10

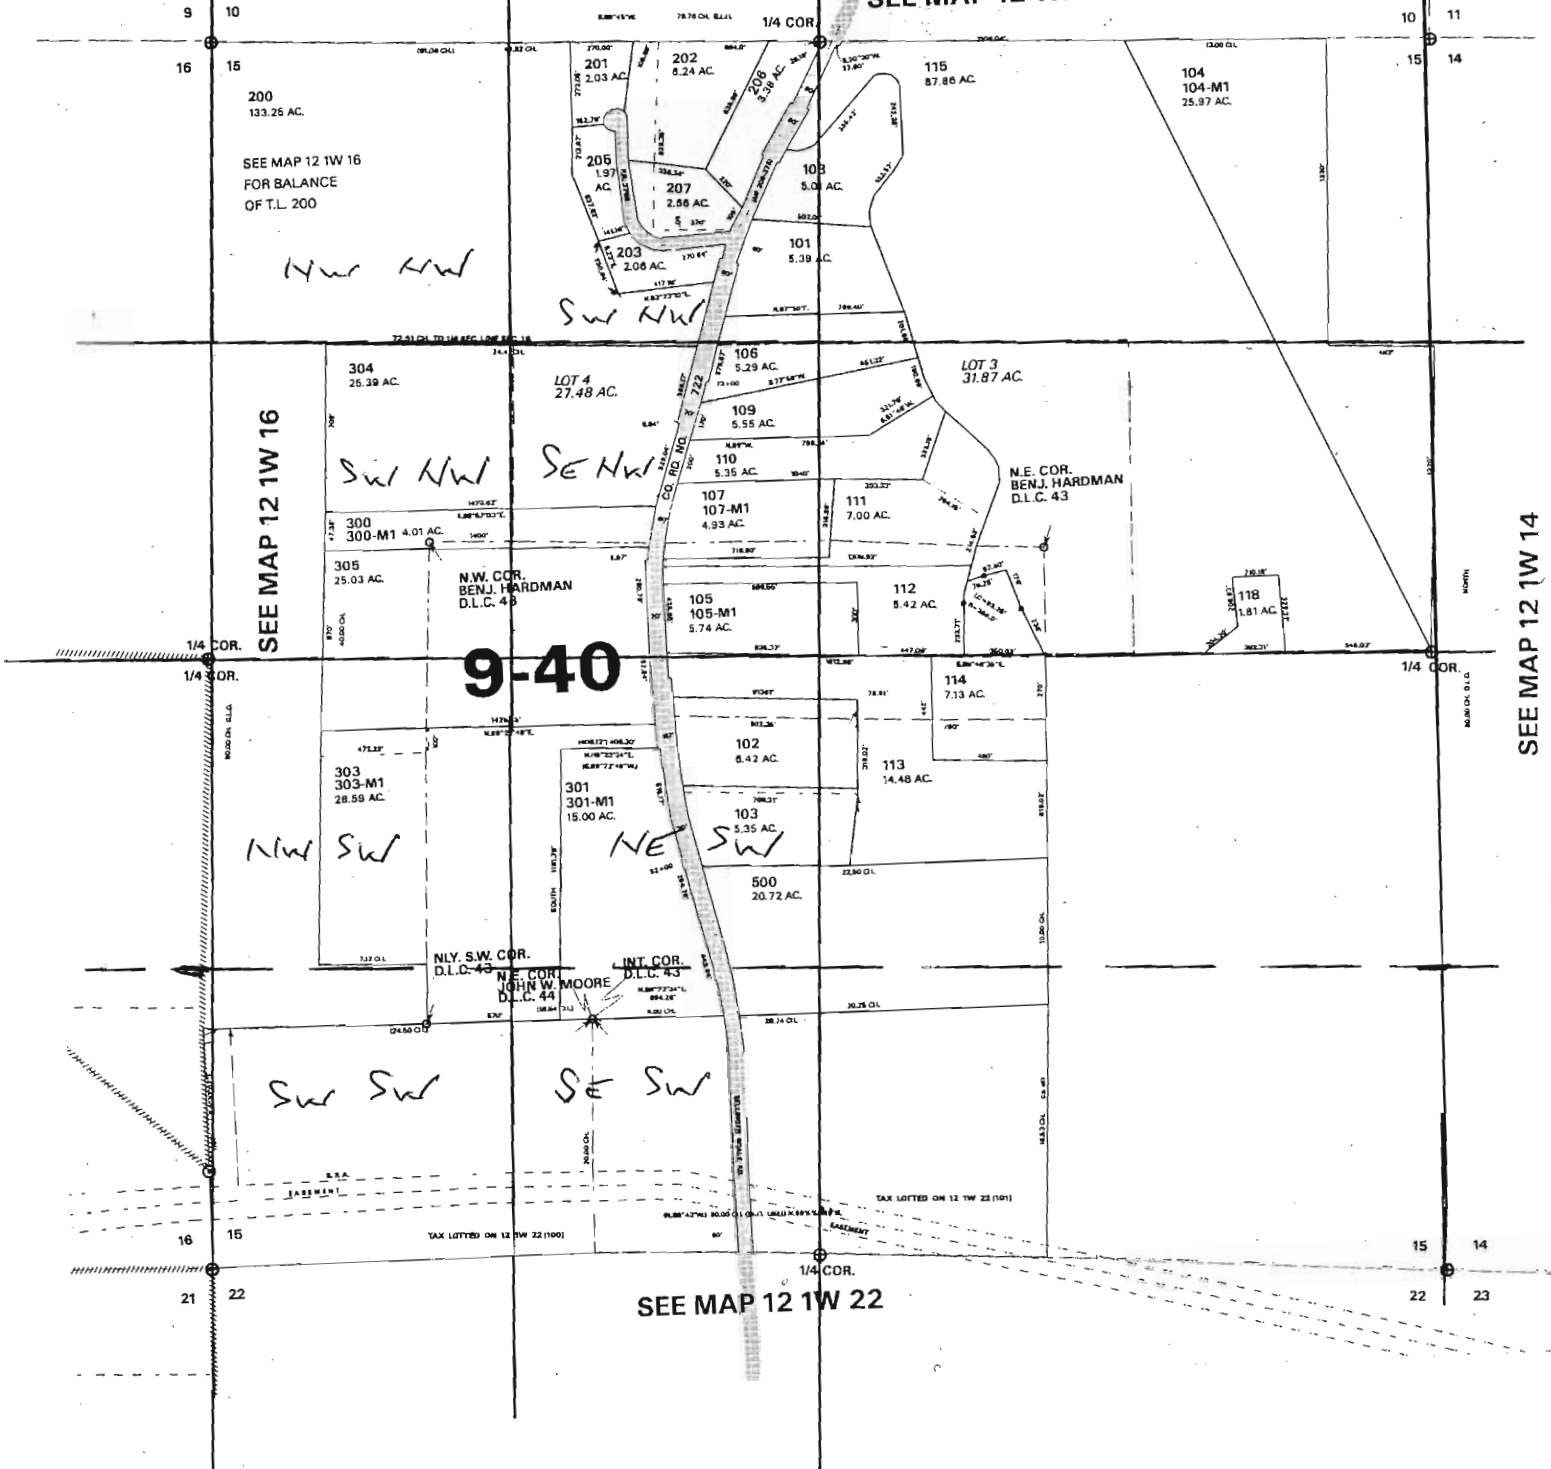

SEE MAP 12 1W 16

SEE MAP 12 1W 14

9-40

SEE MAP 12 1W 22

R-87604