


Dan Daw Tax Lot 400
 for Brown " " 600
 NE of the SW of Sec 23
 Township 7S
 Range 5W

RECEIVED

MAR 12 2010

WATER RIGHTS MAP

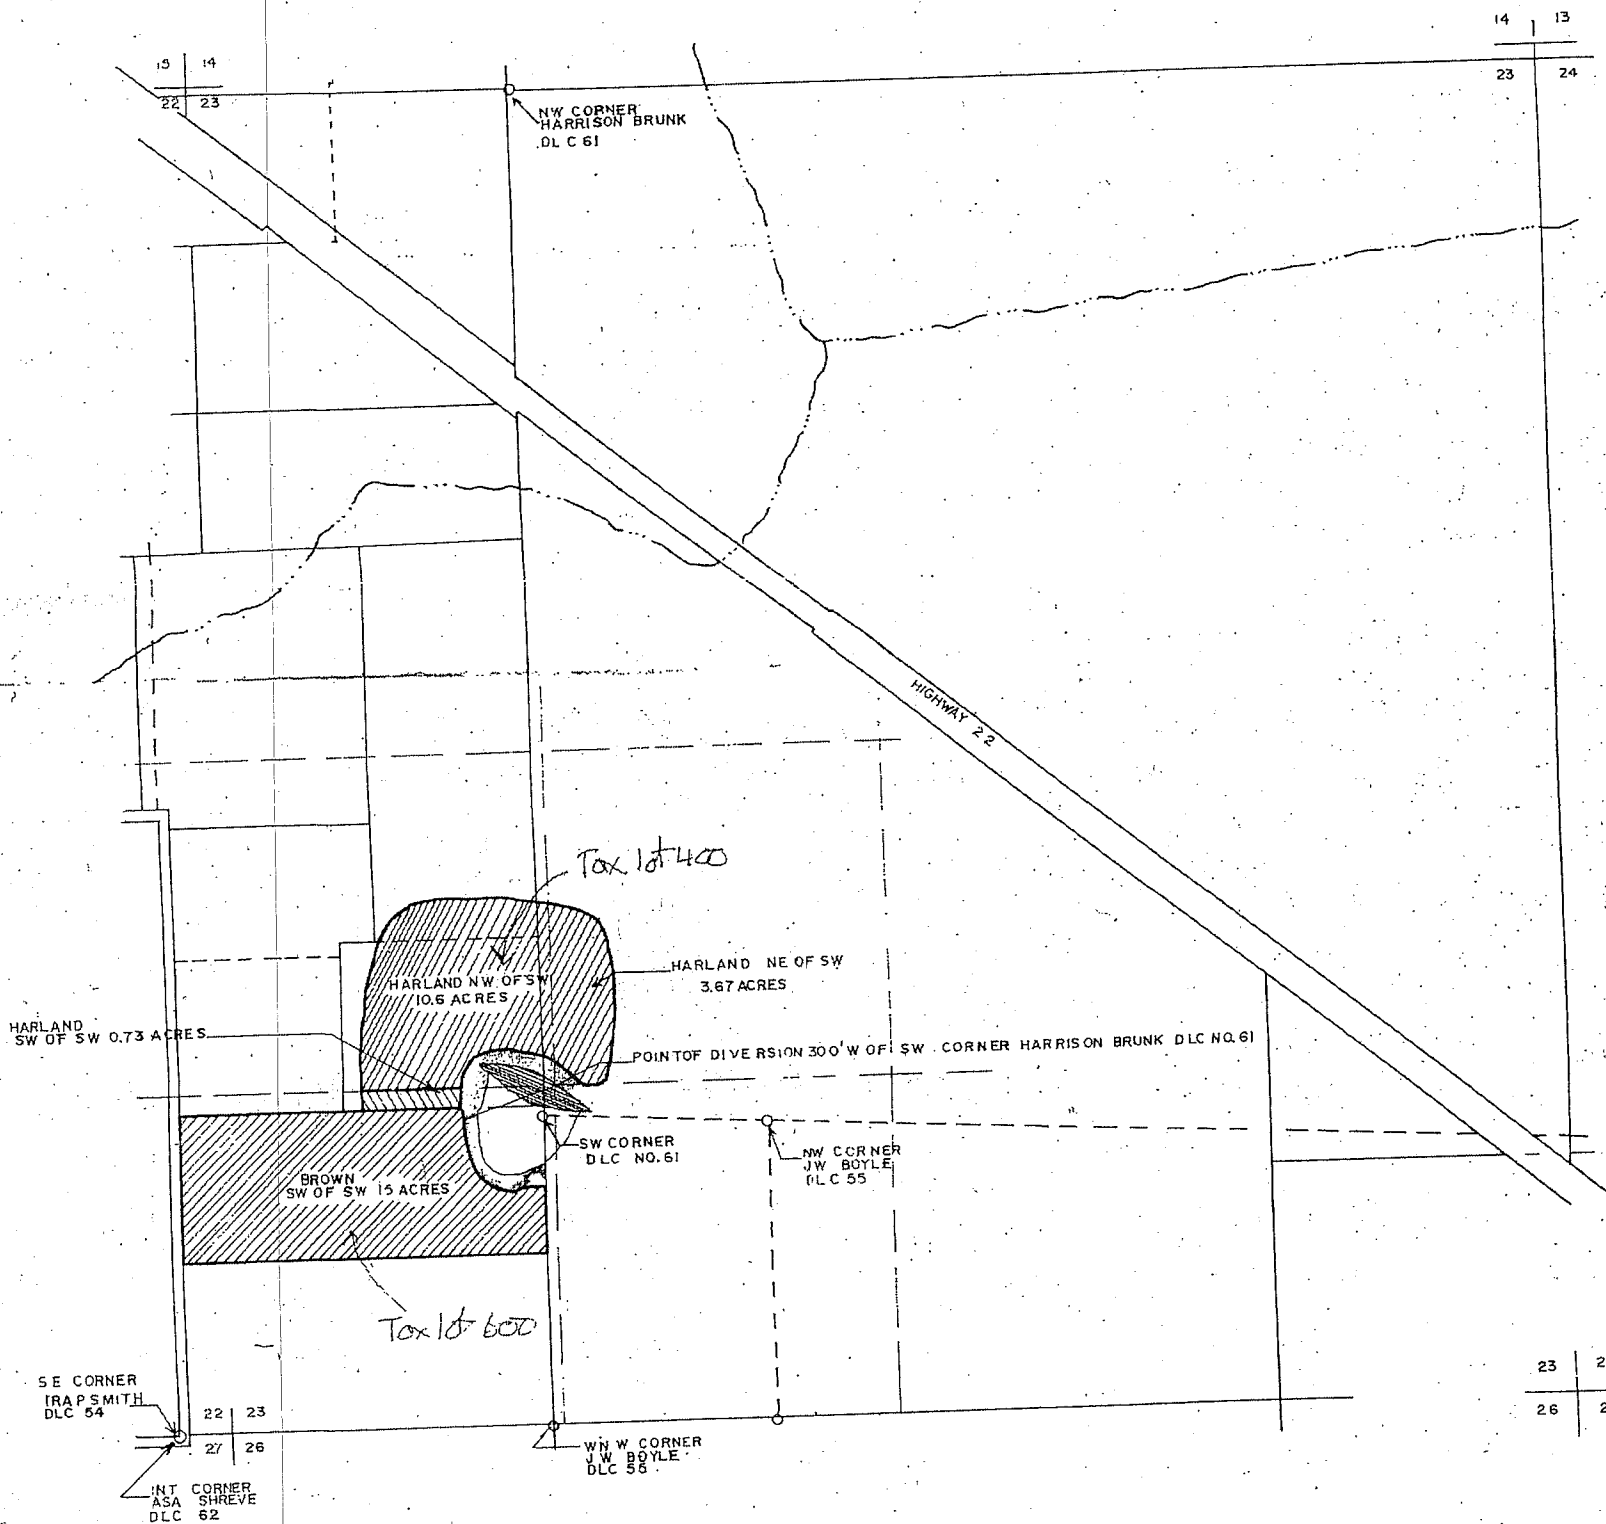

WATER RIGHTS MAP	
KEN BROWN & BILL HARL	
SECTION 23 T 7S R 5W POLK CO.	
Scale: 1"=400'	Date: 8-25-80
Design MGB	M. O. BOATWRIGHT & ASS
Drawn J.D.Z	2613 Twelfth Street
Checked MGB	SALEM, OREGON 97

R-87591