


4S 13E Section 6, Tax Lot 800

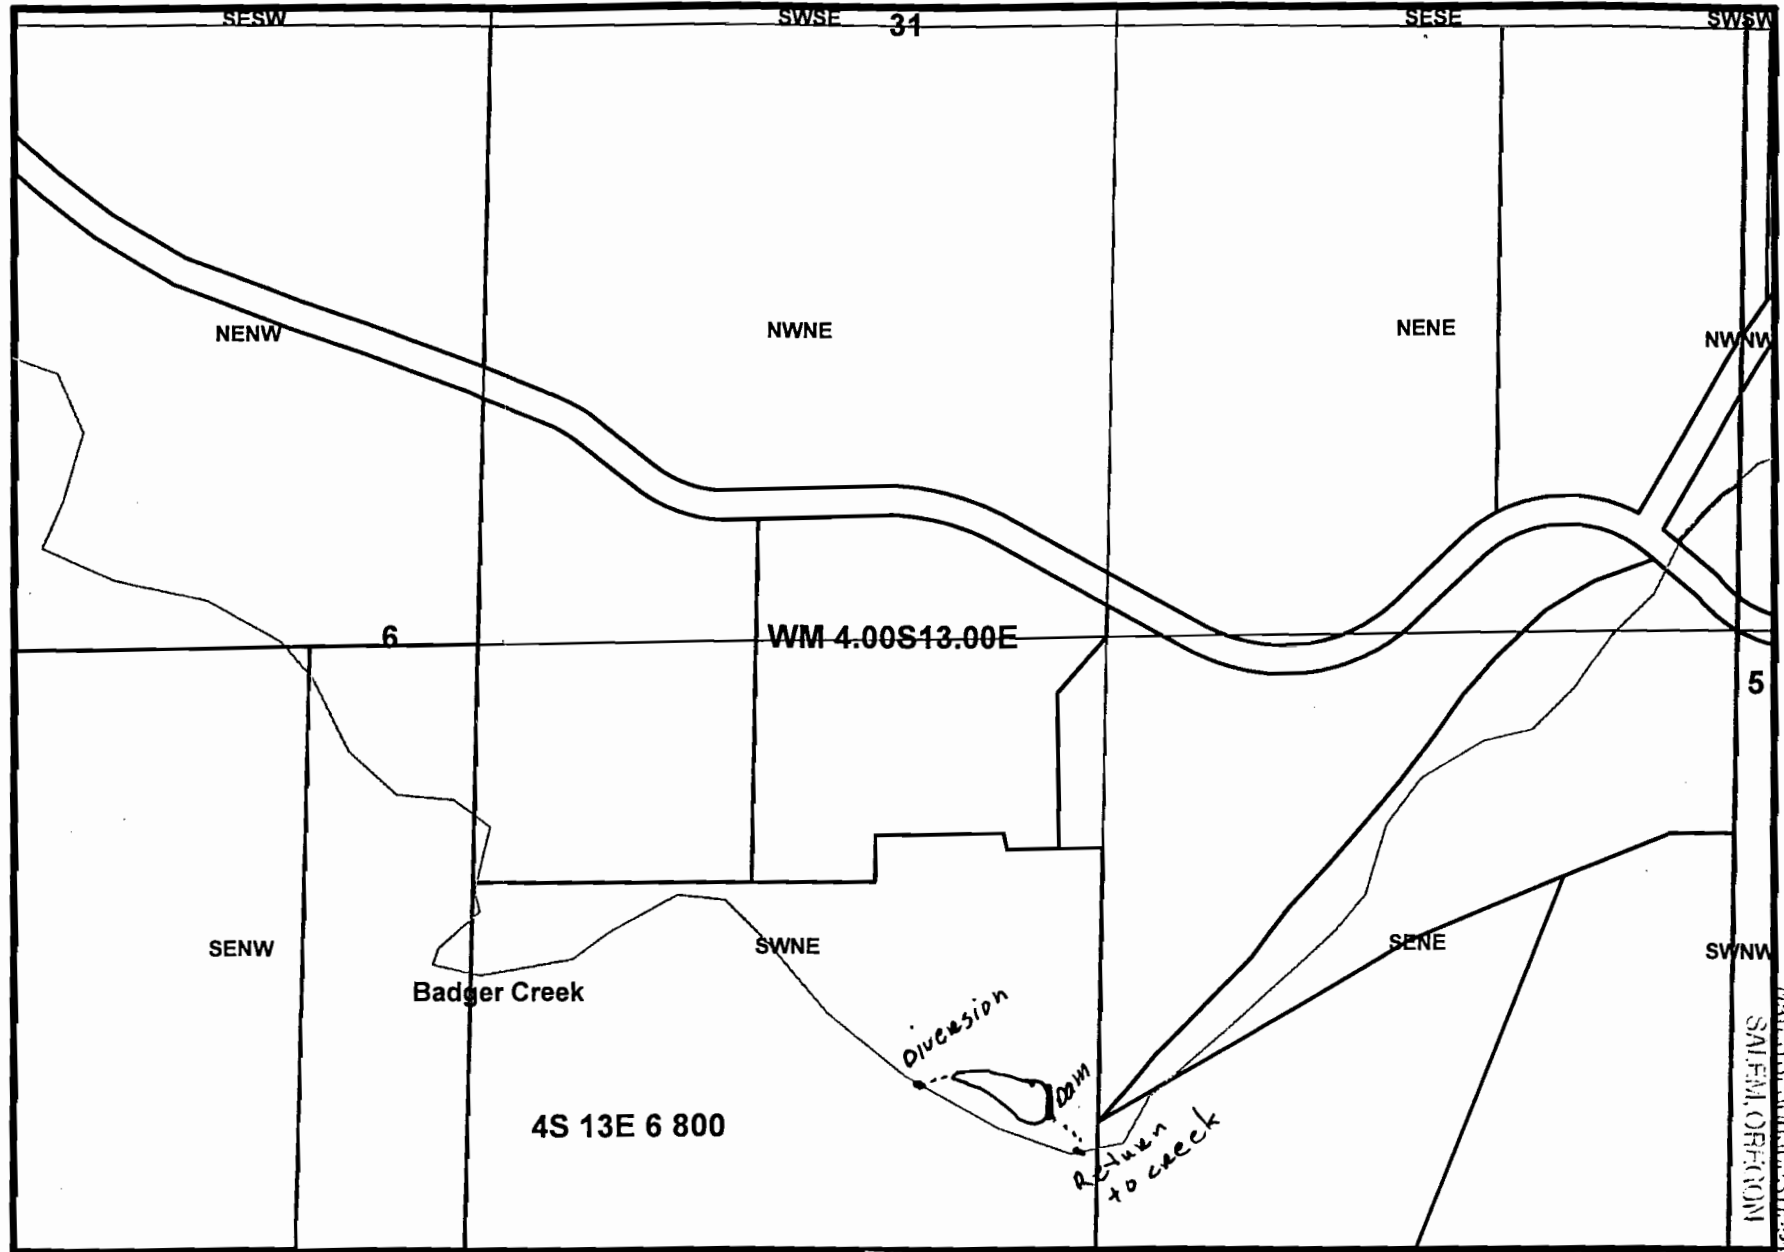

R-87668

NOV 17 2010

RECEIVED

WATER RESOURCES DIVISION
SALEM, OREGON

JUN 29 2011

RECEIVED

*center of dam is approximately 2240' south and 1400' west of NE corner, section 6.

*point of Diversion is approximately 2200' south and 1680' west of NE corner, section 6.

