


Approved through  
ZON 2010-01715

# Proposed Reservoir 35-4W-33-300

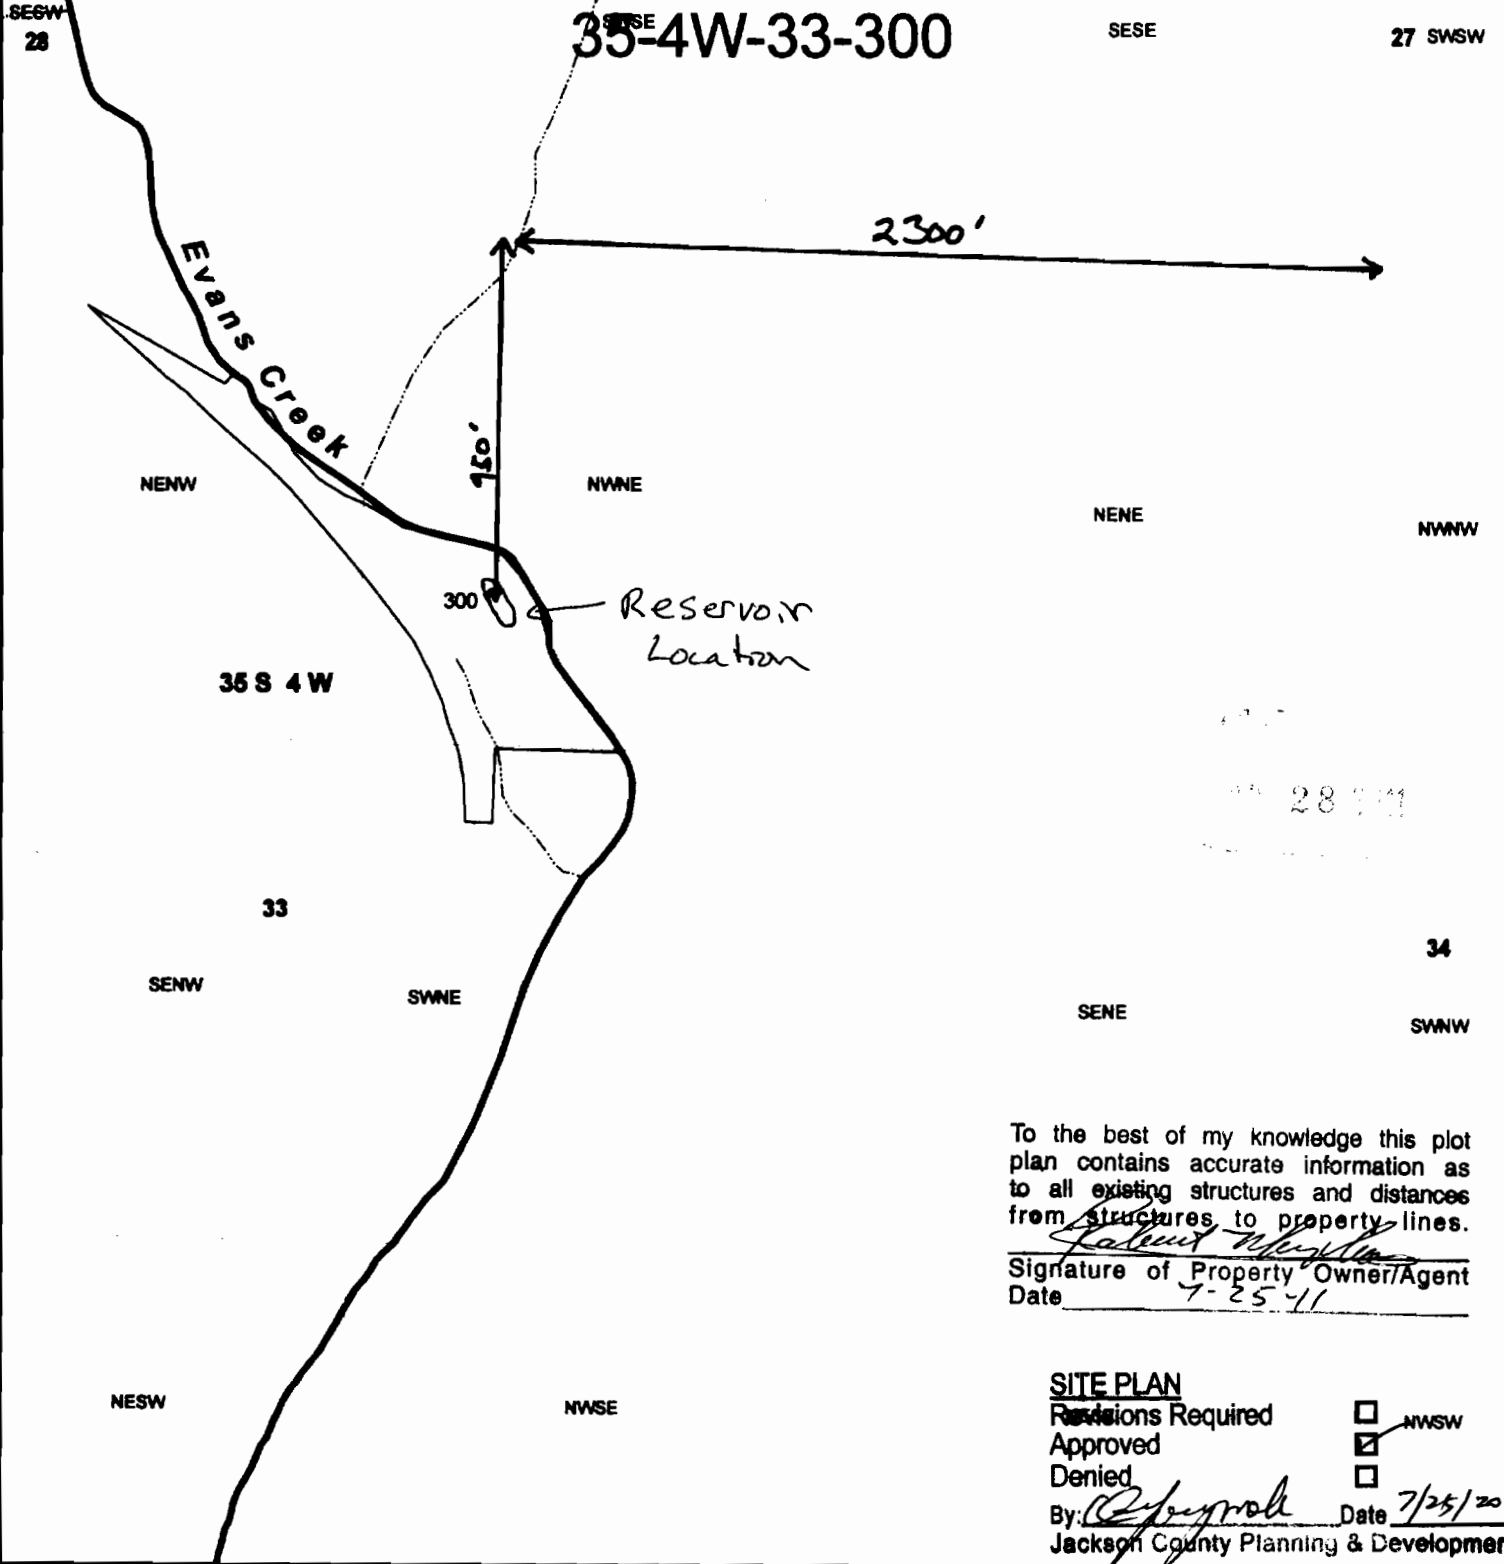


7-28-11

To the best of my knowledge this plot plan contains accurate information as to all existing structures and distances from structures to property lines.

*[Signature]*  
Signature of Property Owner/Agent  
Date 7-25-11

**SITE PLAN**  
 Revisions Required  NWSW  
 Approved   
 Denied   
 By: *[Signature]* Date 7/25/2011  
 Jackson County Planning & Development

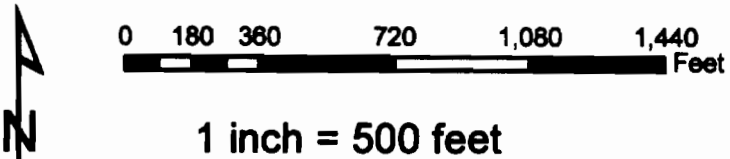

**Legend**  
 Tax Lot      Sections  
 Townships      Quarter quarters

R-07740