

# Multi-Purpose Reservoir Location 34S-2W-9-402-SW/NW

5 SESE

4

SWSW

SESW

Reference  
Corner

NENE

NWNW

NENW

Evans Creek

34 S 2 W  
8

9

**RECEIVED**

AUG 17 2011

WATER RESOURCES DEPT  
SALEM, OREGON

POD Location:  
2456' South & 611' ~~West~~ East  
From the NW Corner of Section 9

SENE

SWNW 402

SENW

RECEIVED

JUL 18 2011

WATER RESOURCES DEPT  
SALEM, OREGON

Morrison Creek

Location of Reservoir:  
2456' South & 792' ~~West~~ East  
From the NW Corner of Section 9

Dam Location:


NESE

NWSW

NESW



1 inch = 324 feet

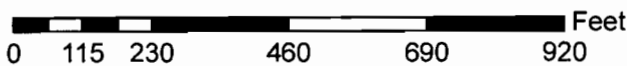

R-87745

**Legend**

- Tax Lot
- Townships
- Sections
- Quarter quarters
- POD
- Reservoir