


T. 5 S. R. 3 W. W.M.

CORRECTED ADJUSTED
APPROX SCALE
1" = 1000 FT.

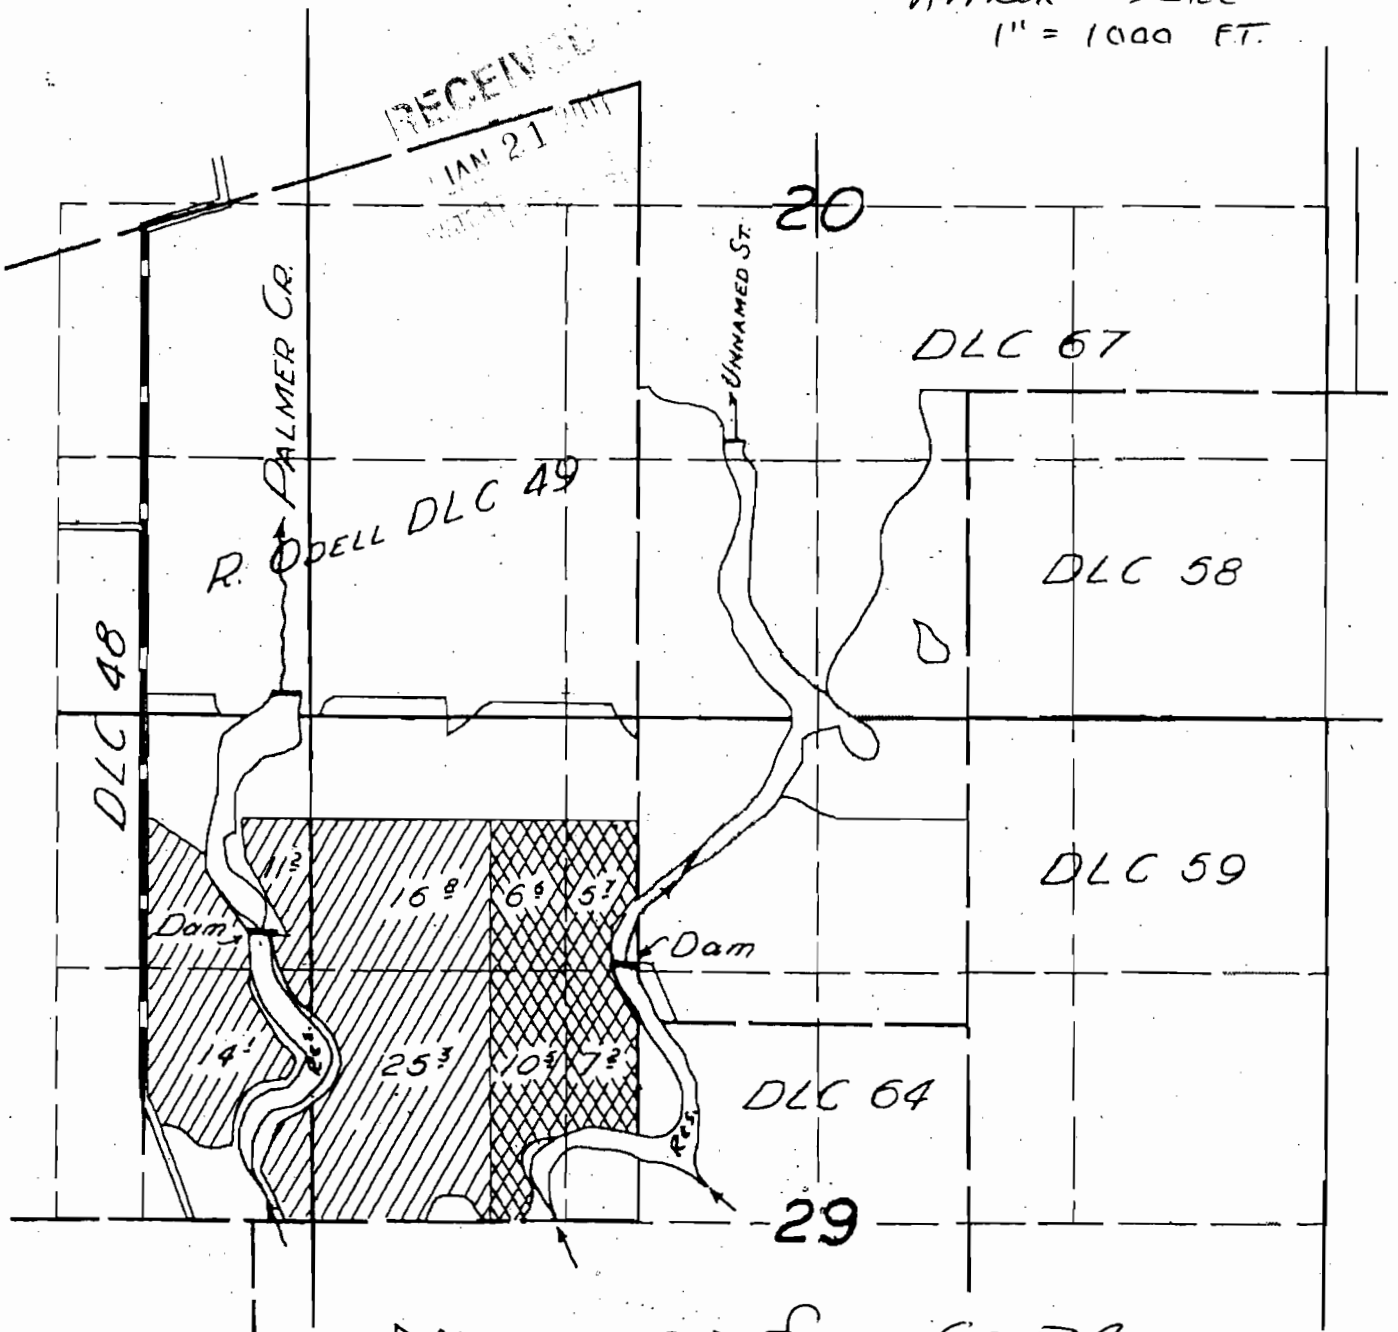

DAM LOCATED FROM CENTER SECTION 20

B. J. Jankl/2011

1215 ft SOUTH
425 ft WEST

R-87683