

**LEGEND**

**LINE TYPES**

- TAX LOT BOUNDARY      OLD PROPERTY LINE
- ROAD RIGHT-OF-WAY      VACATED RIGHT-OF-WAY
- RAILROAD      RAILROAD RIGHT-OF-WAY
- STREAM, LAKE, ETC. TAX LOT BOUNDARY      STREAM, LAKE, ETC. NON-BOUNDARY
- SUBDIVISION BOUNDARY      PARTITION PLAT BDY.
- TAX CODE BOUNDARY      EASEMENT

**SYMBOL TYPES**


- D.L.C.
- CONTROL POINTS
- SURVEY MONUMENTS
- G.L.O. CORNERS
- SECTION      1/4 SEC      1/16 SEC

**NUMBERS**

TAX CODE NO.  
000 00 00 0

ACREAGE - ALL ACREAGES EXCLUDE ANY PORTION THAT MAY LIE WITHIN THE INDICATED PUBLIC RIGHT OF WAYS.

TICK MARKS - WHEN A TICK MARK IS INDICATED ON THE EXTENSION OF A LINE, THEN THE DIMENSION GOES TO THE TICK MARK. GENERALLY THIS IS USED WHEN DIMENSIONS GO INTO PUBLIC RIGHT OF WAYS.

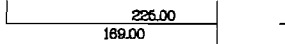

ARROWS ARE USED WITH DIMENSIONS IN AREAS OF GREATER COMPLEXITY.

**NOTICE:** This map was created for Assessor's Office use ONLY.




Varner, Herman and Tomalyn  
Alt Res Application #

SW1/4 NE1/4 SEC.33 T8S R3W WM, MARION COUNTY

**8 3W 33AC**

Cancelled  
200  
301  
401  
501

\*Reservoir Location:  
SENE, Section 33, T8S, R3W,  
1,513 ft East, 370 ft North, from Center Section 33  
Tax Lot 100

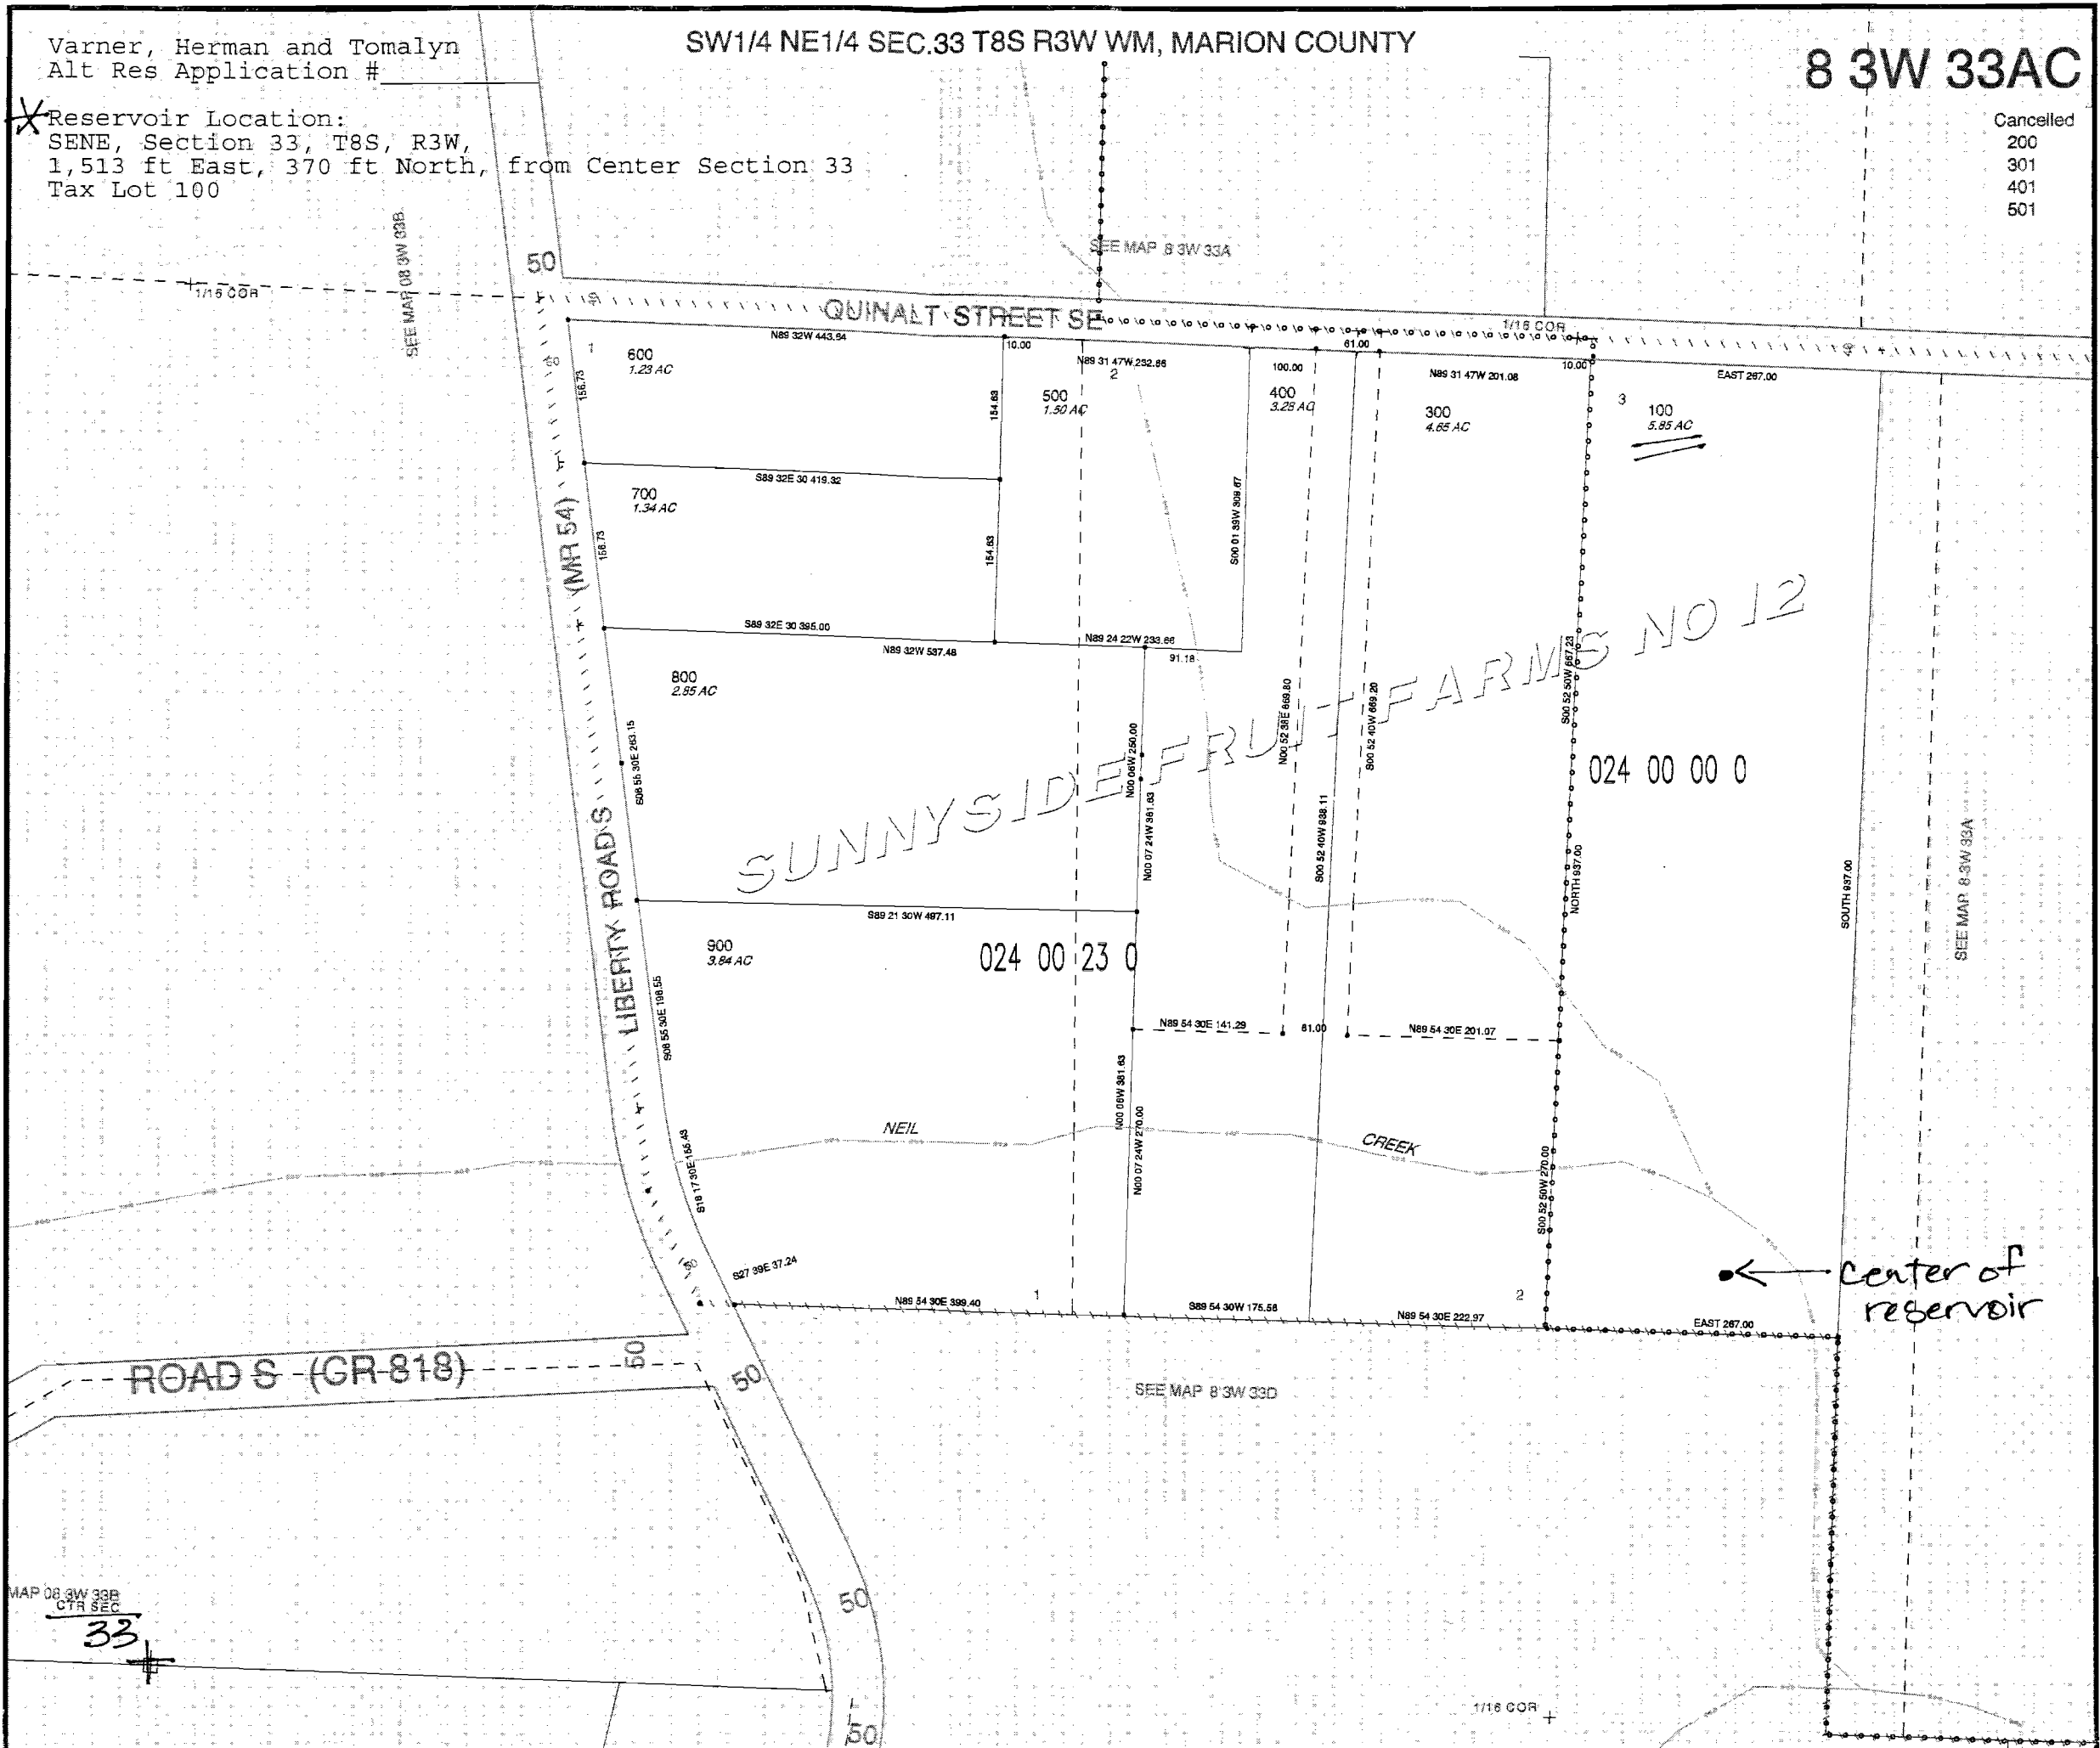

MAP 08 3W 33B  
CTR SEC

33

1/16 COR