

WINCHUCK

RIVER

APPROX COLLECTED  
ADJUSTED SCALE  
1" = 300 FT

SEE MAP 41S 13W 23D

1/4 SEC.26 T.41S. R.13W. W.M.  
CURRY COUNTY


17-5

CS 41-1228


RESERVOIR  
LOCATED FROM  
NE CORNER  
SECTION 26  
2230 ft So.  
1370ft W.

SEE MAP 41S 13W 25

U.S.  
HWY.  
101

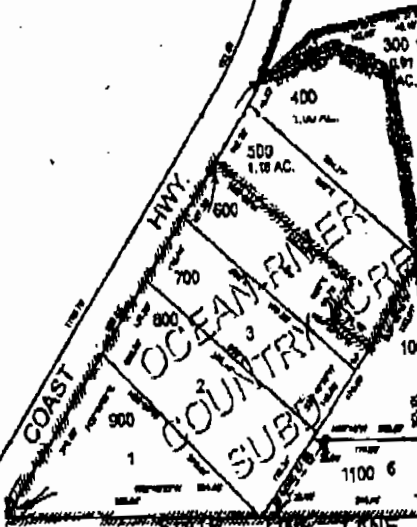

STATE LINE LANE

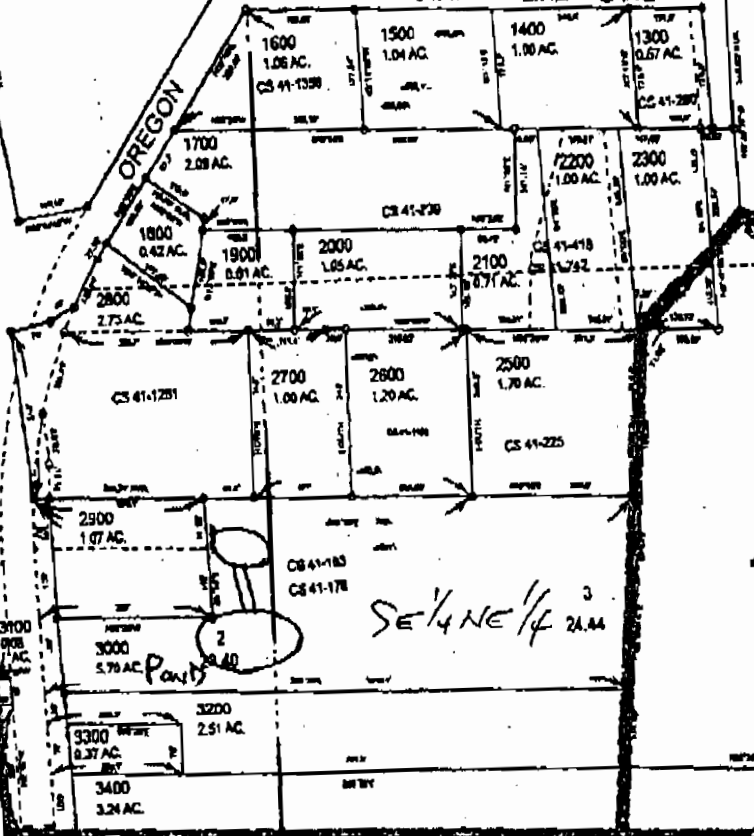

17-6

SE 1/4 NE 1/4 2A.44

SW 1/4 NE 1/4

CALIFORNIA

R-87748

WINCHUCK

RIVER

SEE MAP 41S 13W 23D

APPROX CORRECTED  
ADJUSTED SCALE  
1" = 300 FT

23 24

26 25


SE 1/4 SEC. 26 T. 41S. R. 13W. W.M.  
CURRY COUNTY

17-5



CS 41-1226

RESERVOIR  
LOCATED FROM  
NE CORNER  
SECTION 26  
2230 ft So.  
1370 ft W.

U.S.  
HWY.  
101

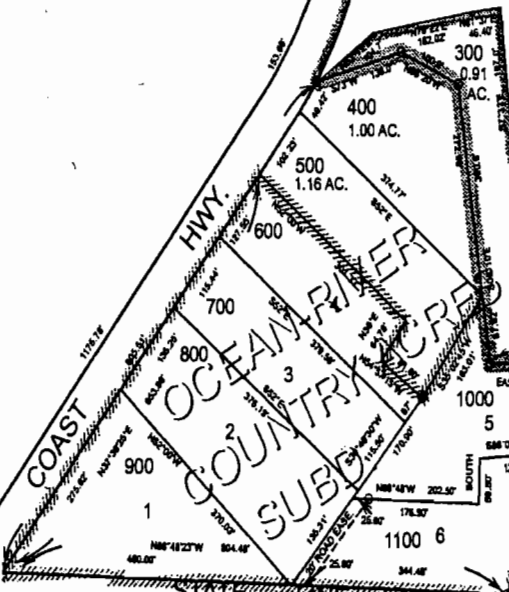

SEE MAP 41S 13W 26

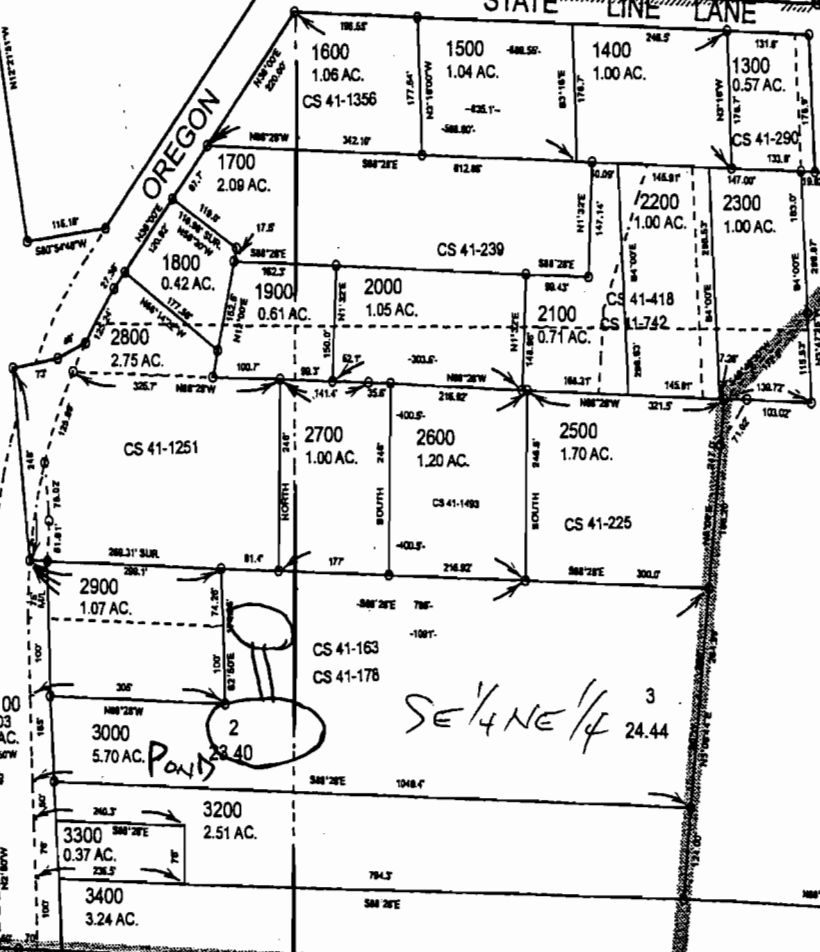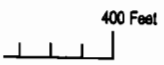

SE 1/4 NE 1/4 3  
24.44

17-6

SW 1/4 NE 1/4

R-87748

CALIFORNIA

26 25