


# T35S R6W Southwest Quarter

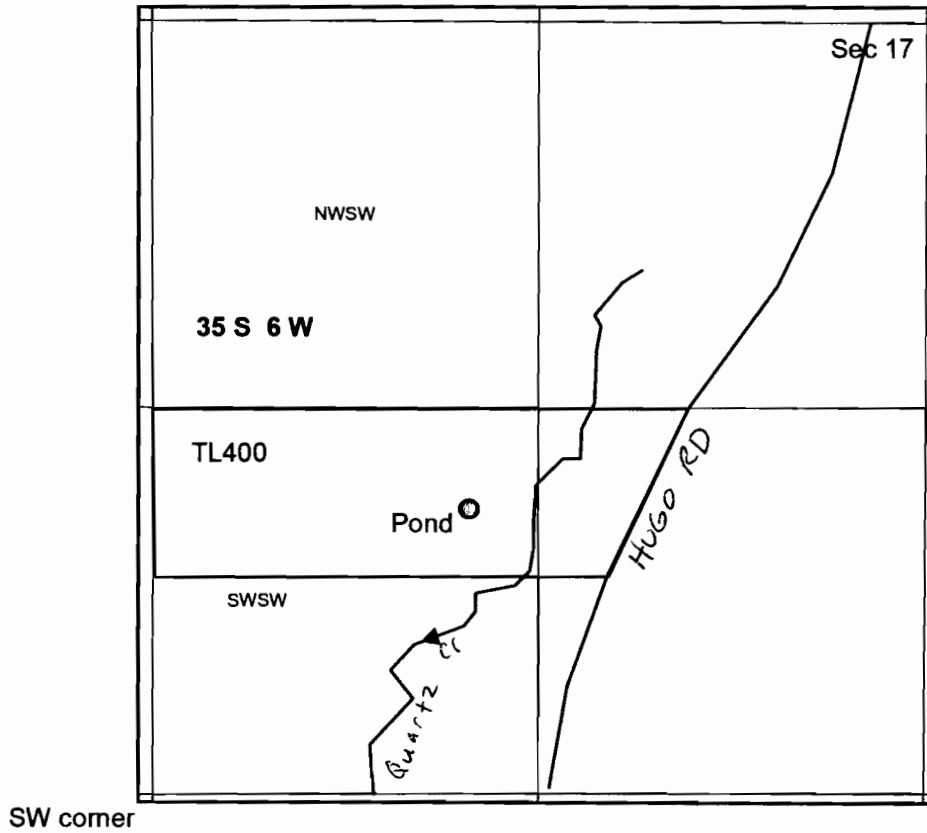

Pond is 1076 feet east and  
970 feet north from the  
SW corner sec 17.

1 inch = 660 feet

RECEIVED BY CLERK

SEP 26 2012

SALEM, OR

R-87841