


RECEIVED BY OWRD

JUL 23 2012

SALEM, OR

HUKOH Pond

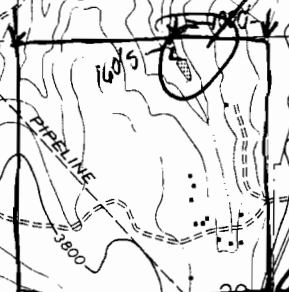

EMIGRANT SPRING STATE PARK
Campground


Campground
Water Tank

RECEIVED BY OWRD

AUG 06 2012

SALEM, OR

R-87820

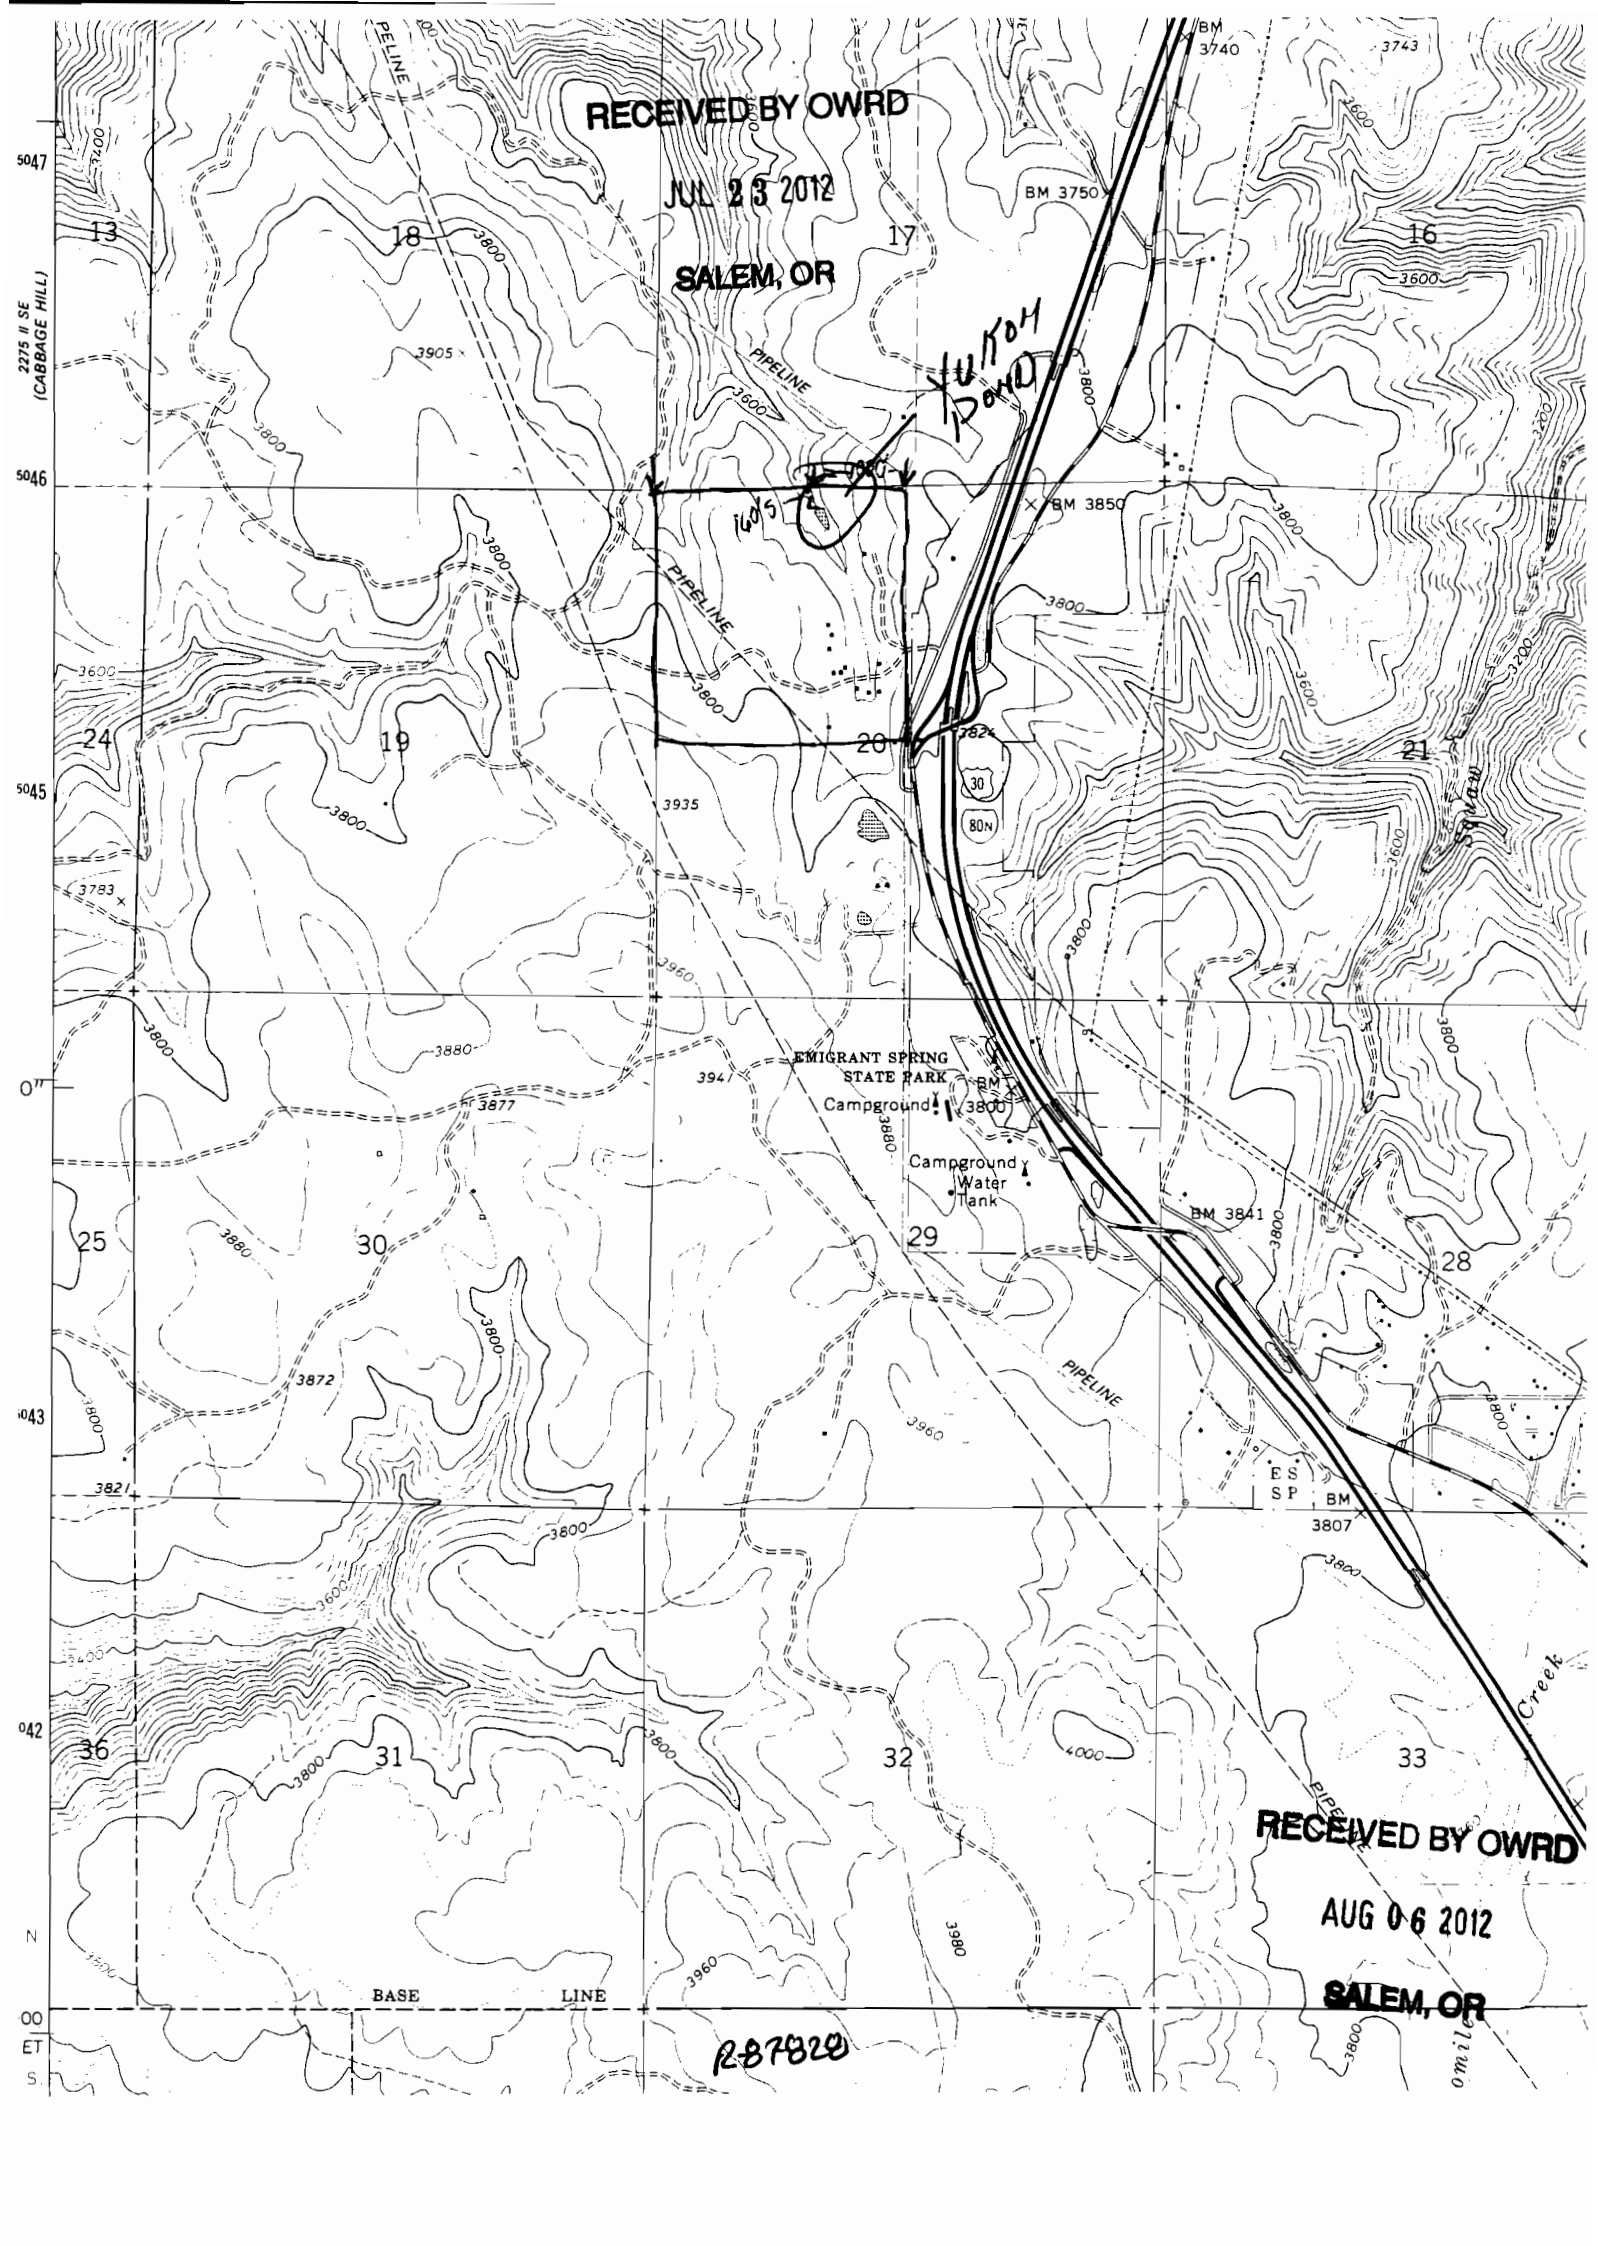

RECEIVED BY OWRD

JUL 23 2012

SALEM, OR



NW COR of NE NW

T 1 N R 35 E

SEE MAP 1N35

Section 20 NENW

Dam location: 160' south and 1000' west from the N 1/4 corner of Section 20

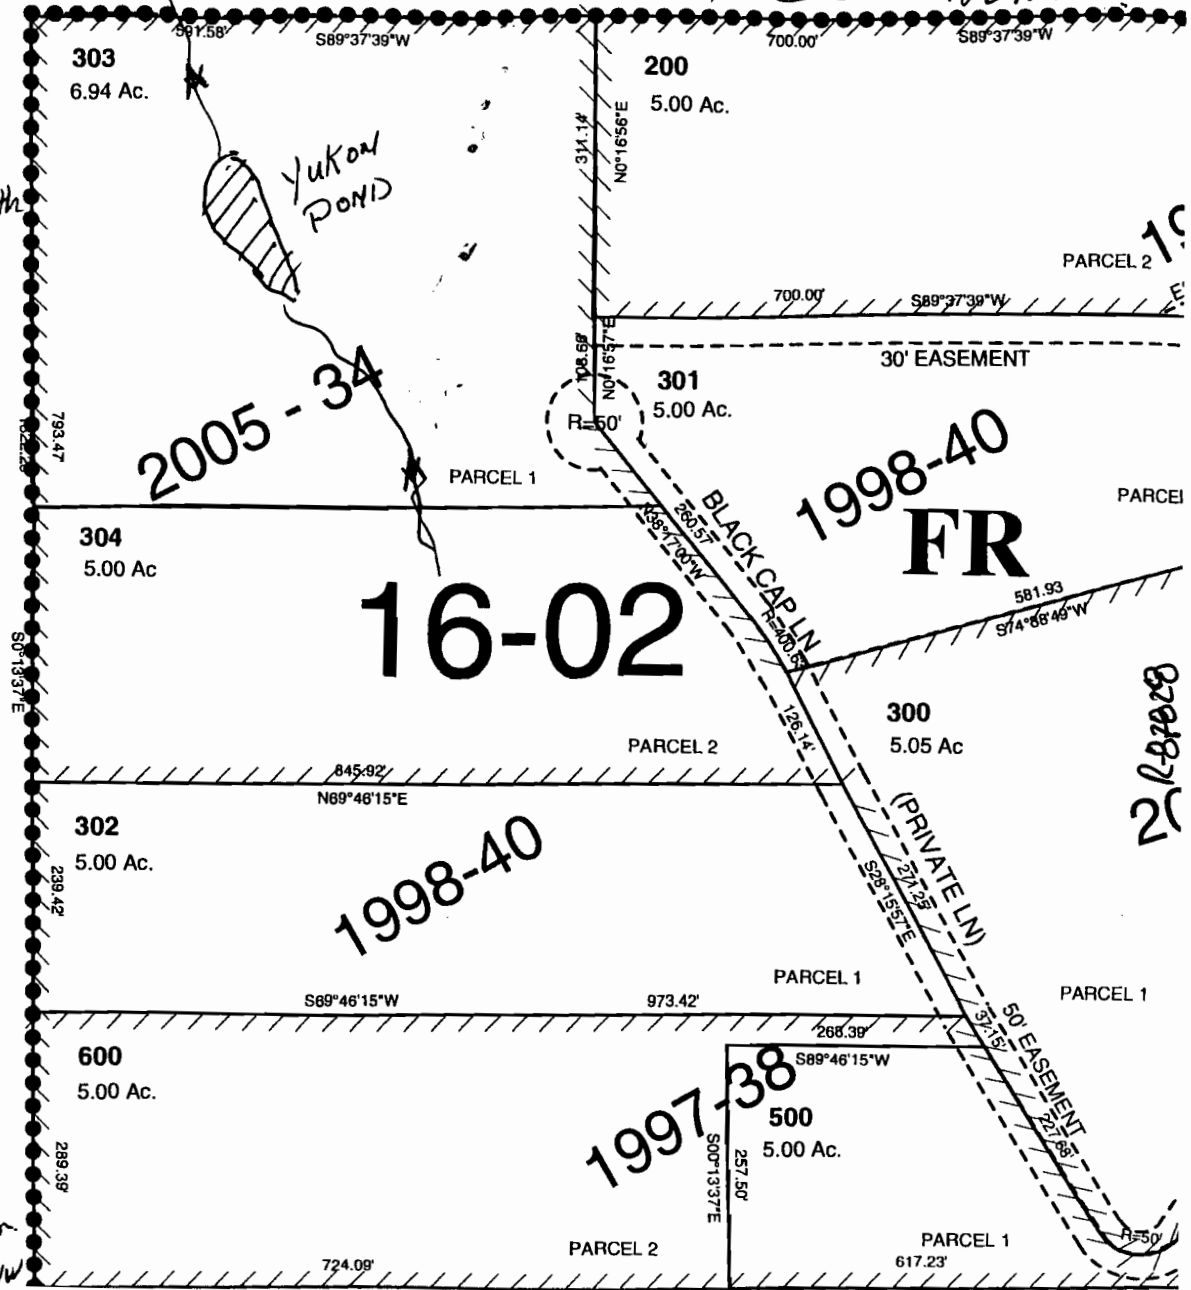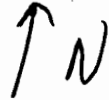

SEE MAP 1N35

1" = 200'

SALEM, OR

AUG 14 2012

RECEIVED BY OWRD