


SECTION

Section 34


Tax Lot 201

1" = 1320

TOWNSHIP 9<sup>South</sup>, RANGE 5<sup>West</sup>, W. M.

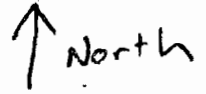

North

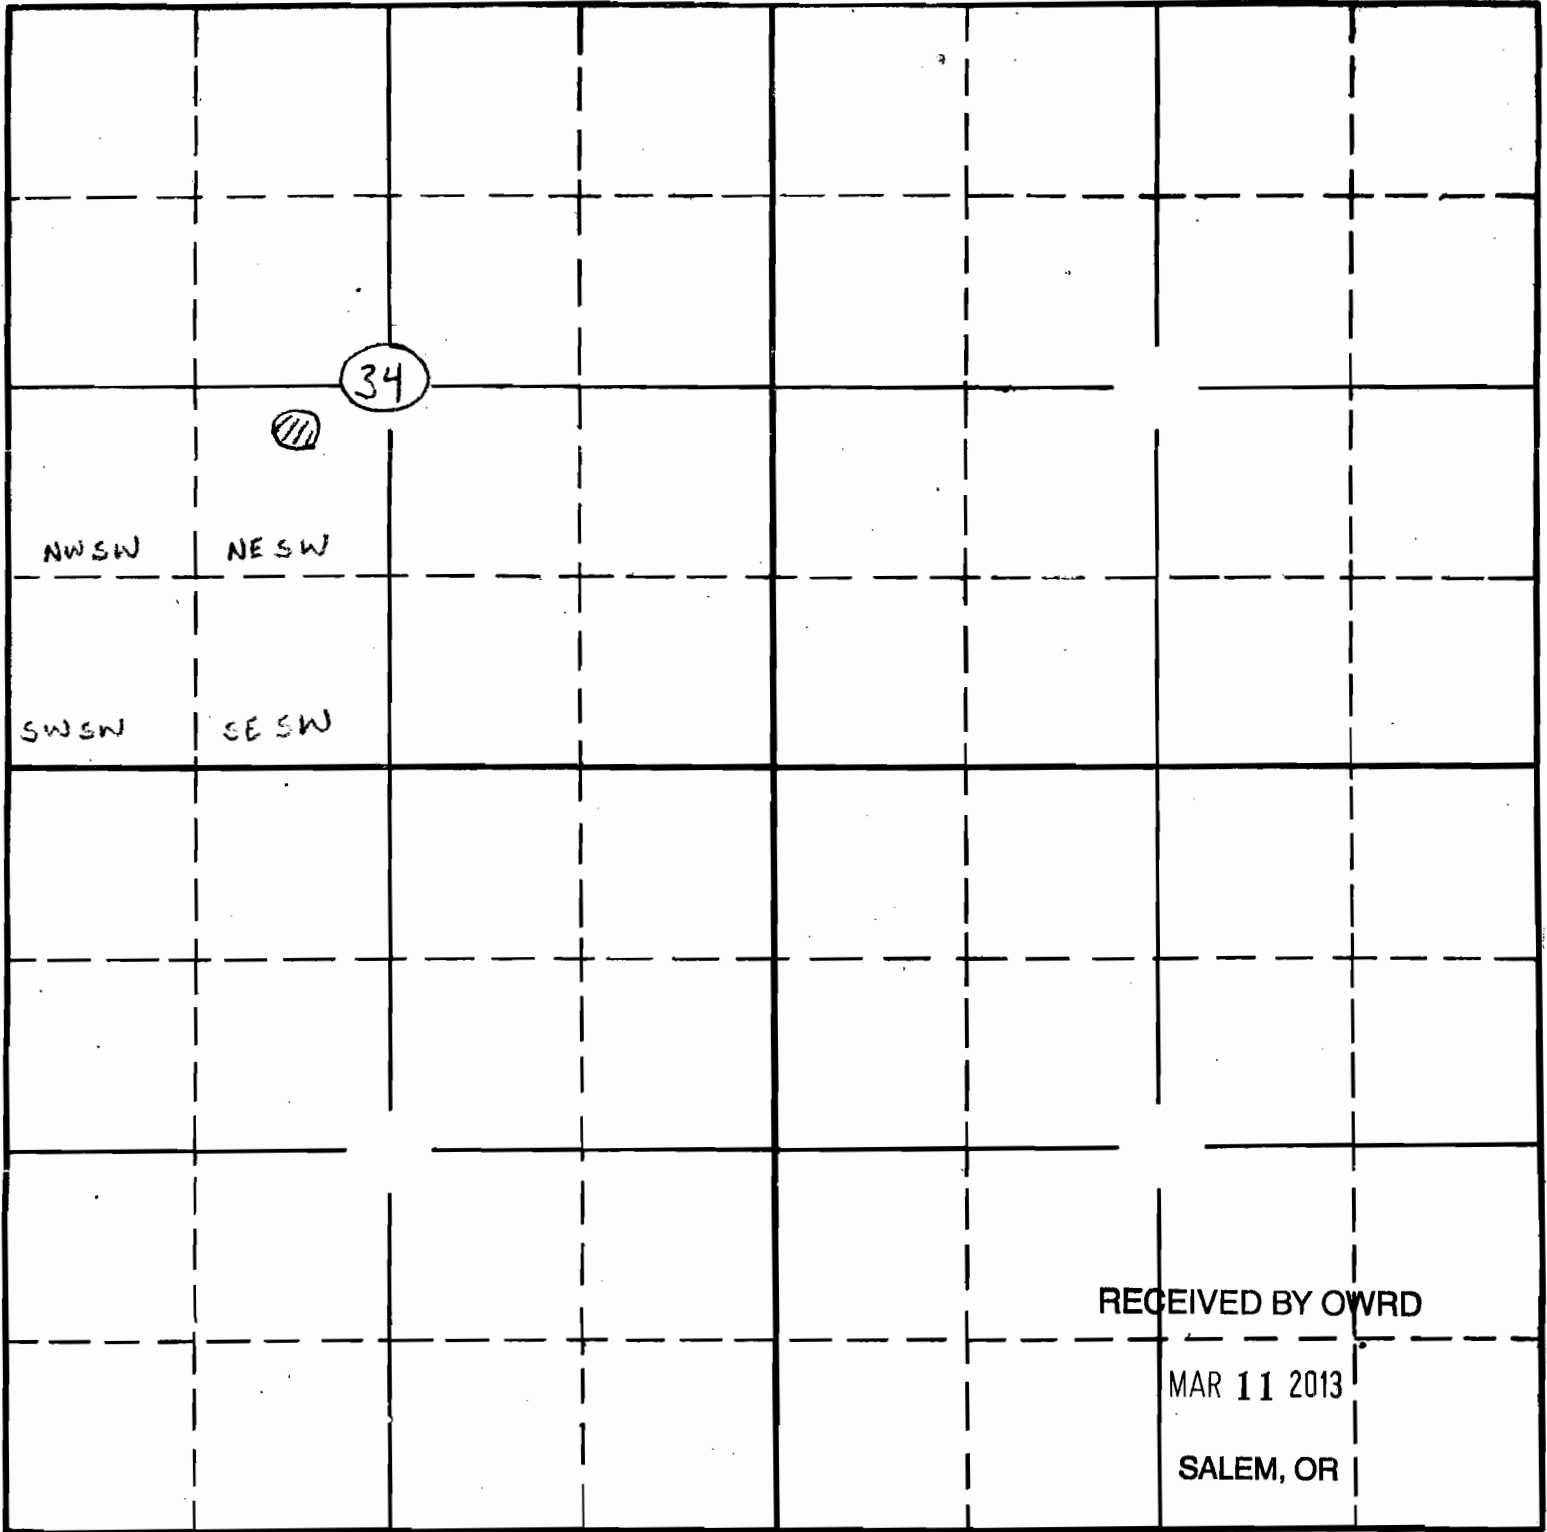

South

Dom Loc; 170 feet South 770 feet West  
from Center of Section 34

APPLICATION No.  
PERMIT No.

Marvin White 3-6-13  
Jerry Kruck 3-6-13