

"SCALE"

1" = 400'



S.E. 1/4 SEC. 21 T.2S. R.1E. W.M.
CLACKAMAS COUNTY

D. L. C.
EDWARD A. WILSON NO. 72

2 IE 21D




CANCELLED TAX LOTS
1001
903

This map was prepared for
assessment purpose only.

1" = 200'
700'
300'

1300

300

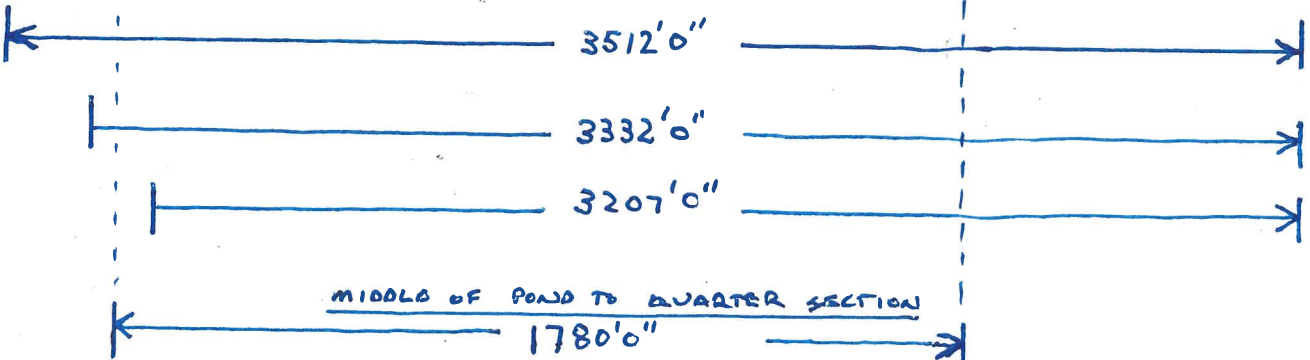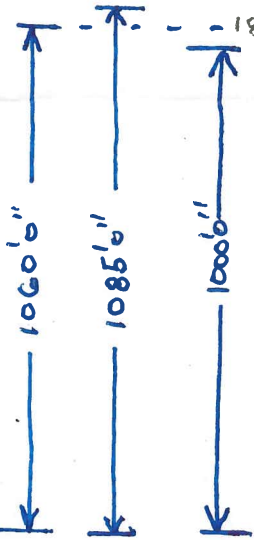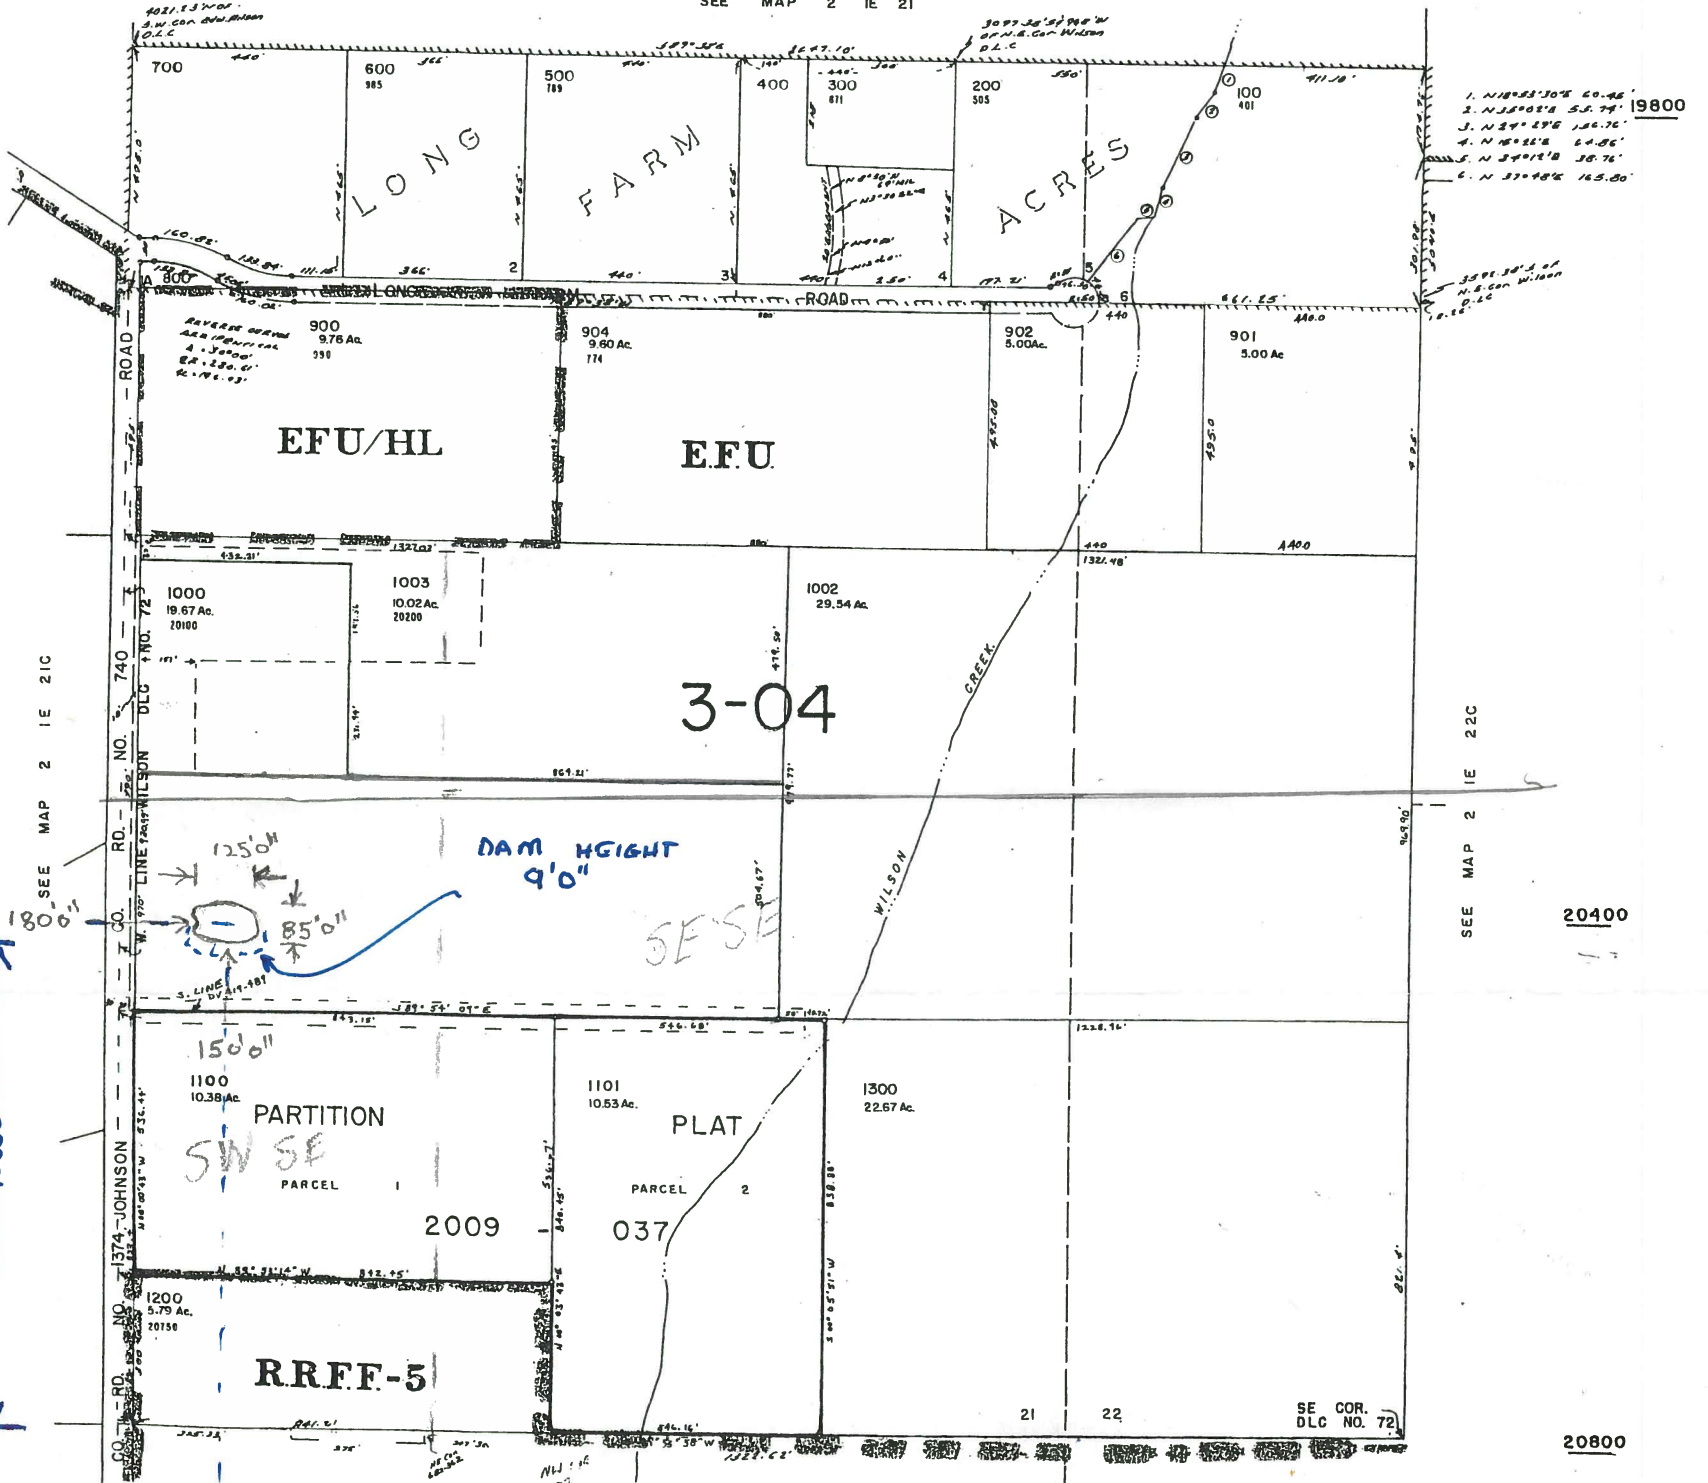

S.E. 1/4 SEC. 21

T.2S. R.1E. W.M. CLACKAMAS COUNTY

* QUARTER / QUARTER

SW / SE

RECEIVED

OCT 23 2012

WATER RESOURCES DEPT
SALEM, OREGON

T.B.A.
2 IE 21D
BOOK 12

20400

20800

19800