


**SCALE 1" = 500' APPROX.**

**IMPORTANT**  
This Map for Assessment  
and Taxation Purposes  
**ONLY**

**NW1/4 SEC.5 T8S R5W WM**  
**POLK COUNTY**

**Scale 1" = 200'**

**8.5.5B**

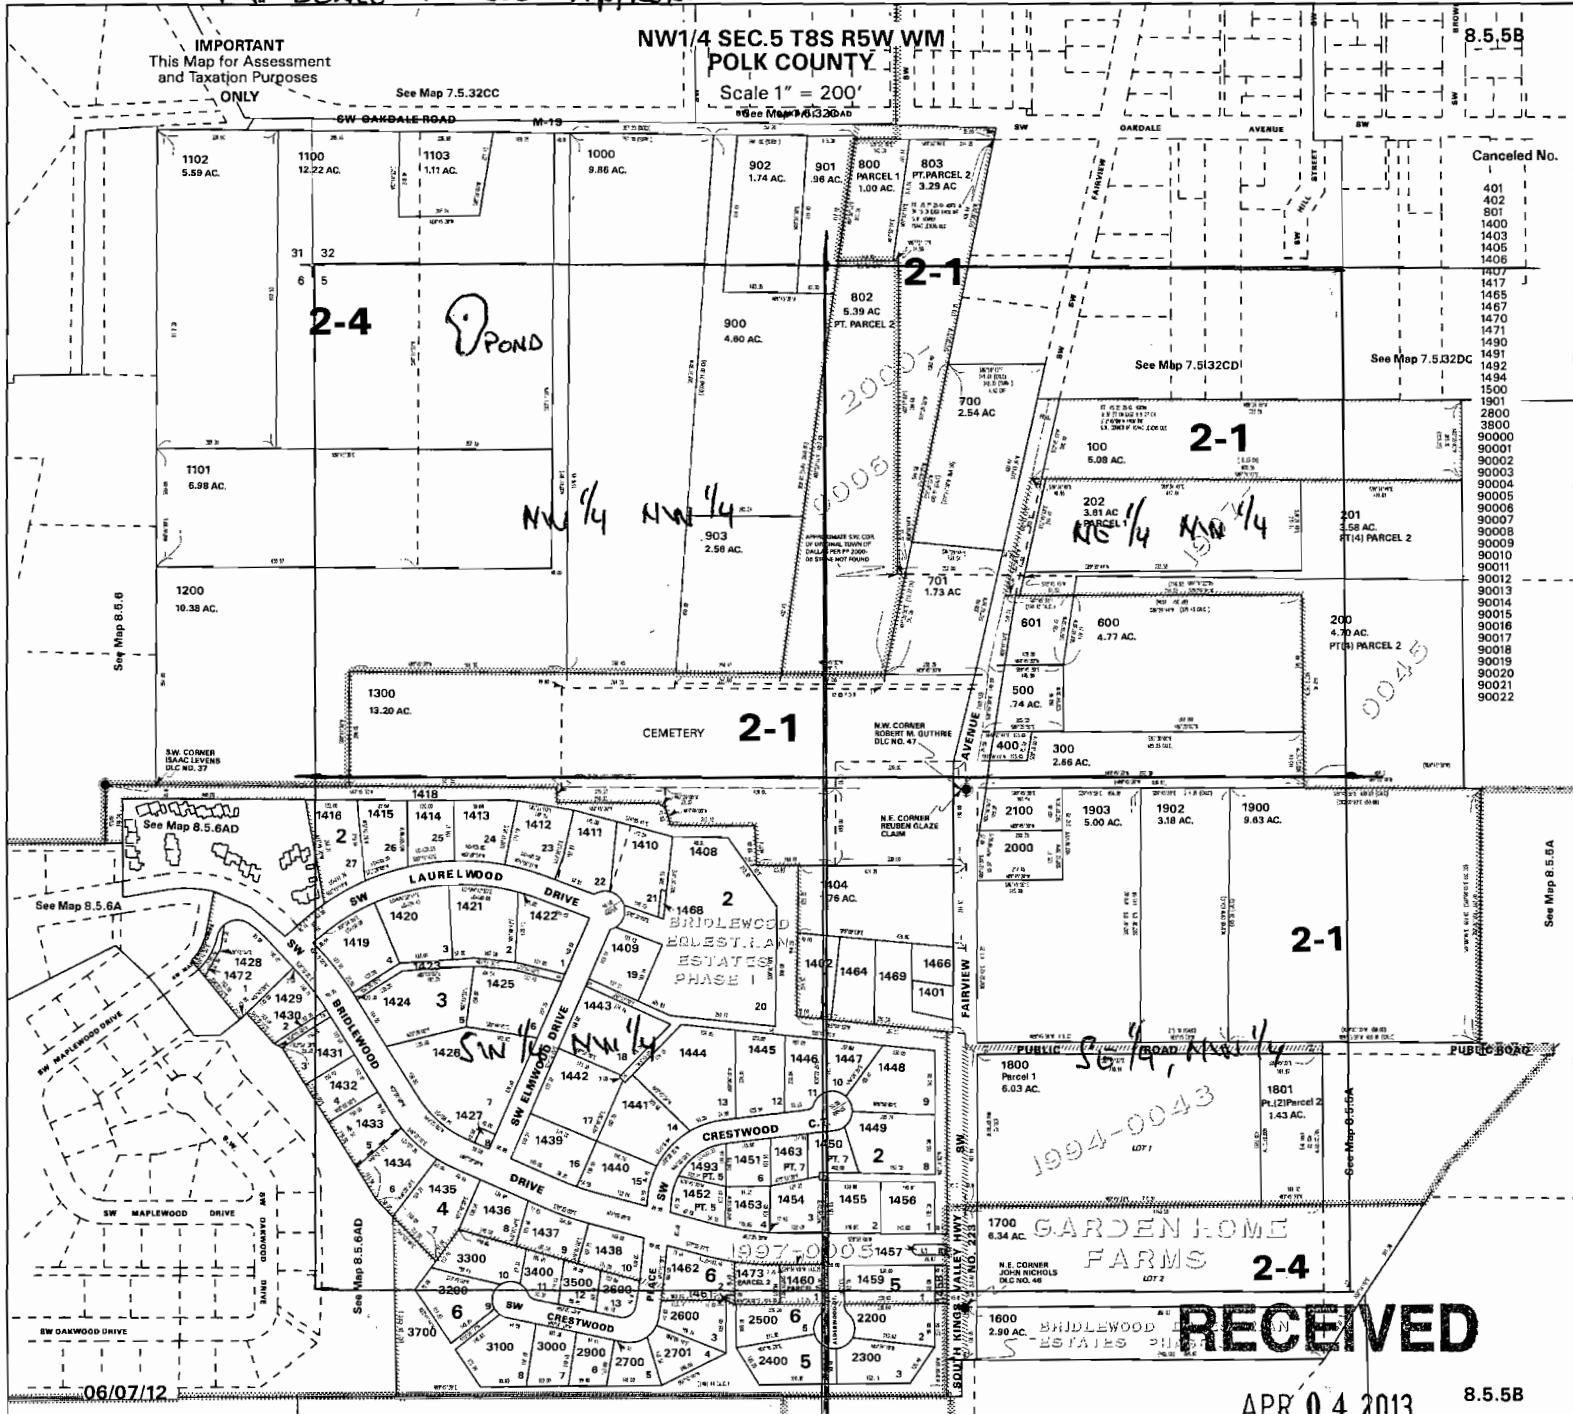

**WATER RESOURCES DEPT**  
**SALEM, OREGON**

130' SOUTH  
400' EAST FROM NW1 SECTION CORNER, SECTION 5  
R-87884