


Work Copy

Scale  
1" = 500'

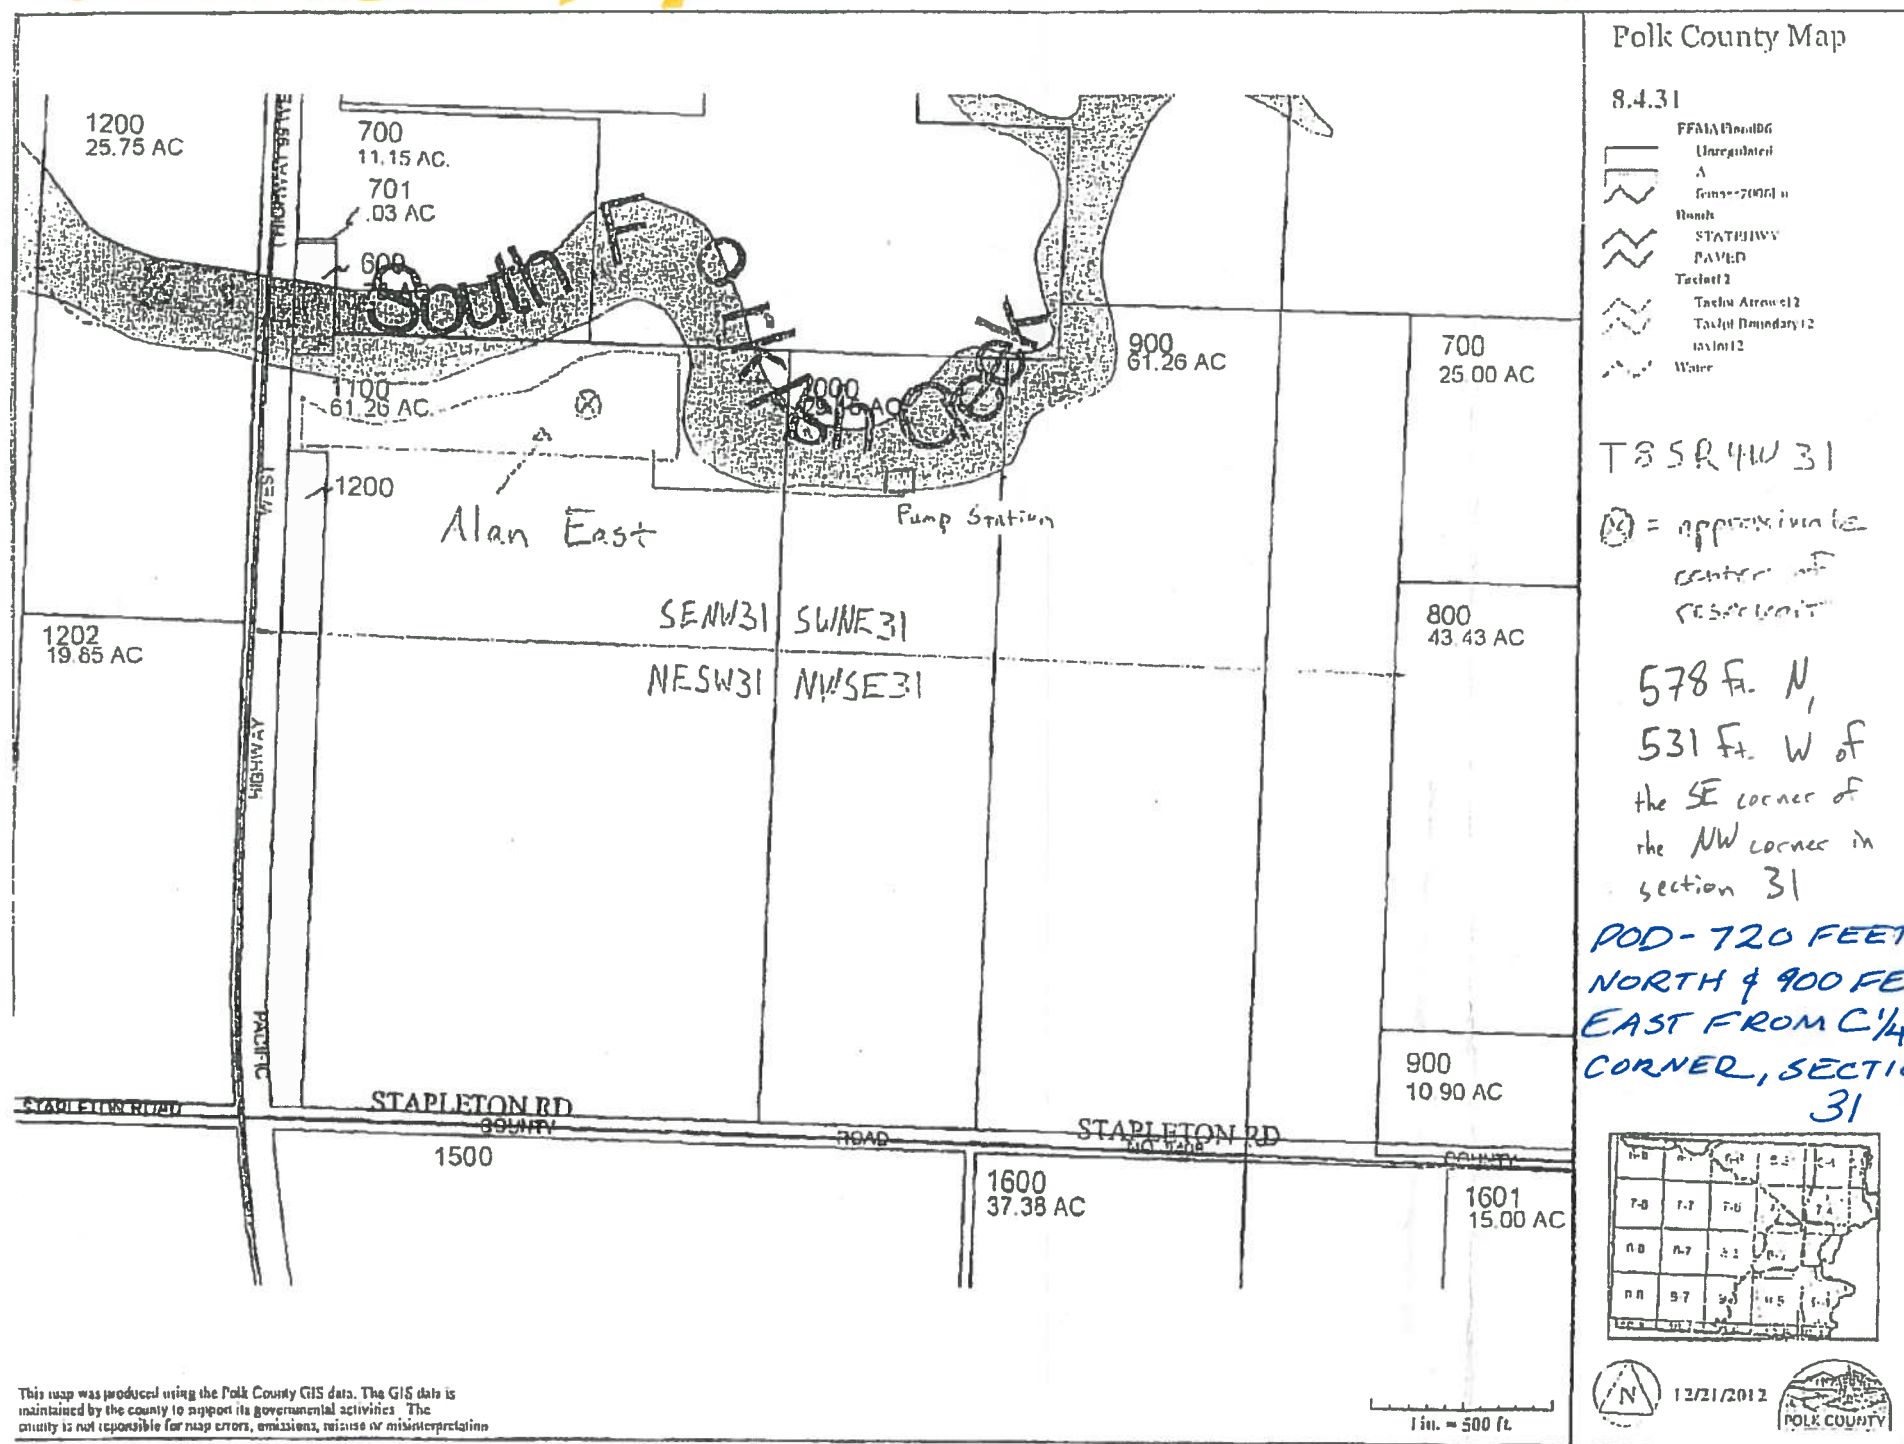

R-07910