


Section 7  
 T. 4 N., R. 29 E.W.M.

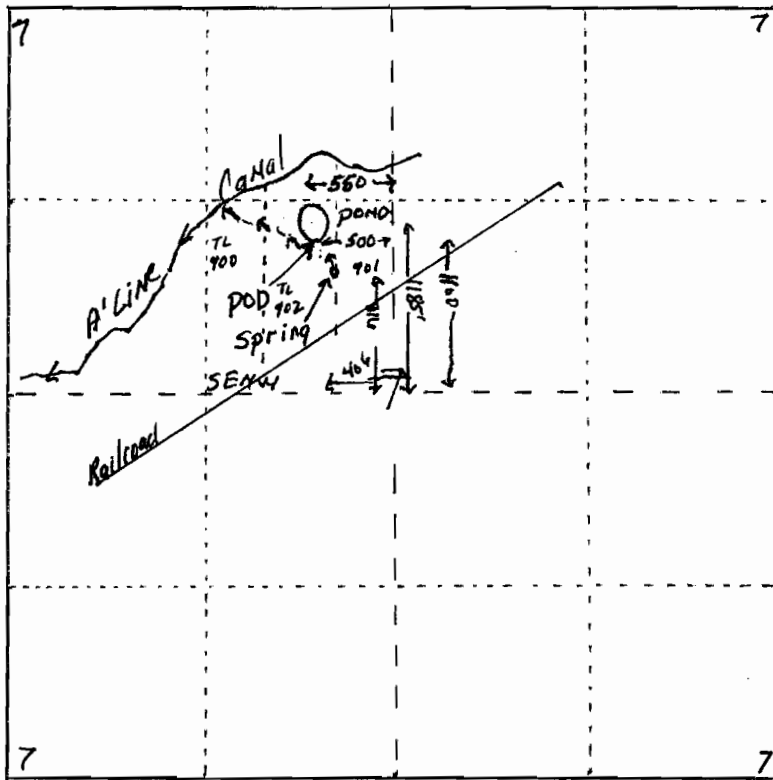

4 in = 1 mile

pond 1185' N. 550' W.  
 Spring 406' W. 816' N.  
 POD 1100' N. 500' W. } of center of  
 Section 7

tax lot 902, 4 N 2907B

RECEIVED BY OWRD

JUN 24 2013

SALEM, OR

MAY 22 2013

SALEM, OR