


1" = 400'

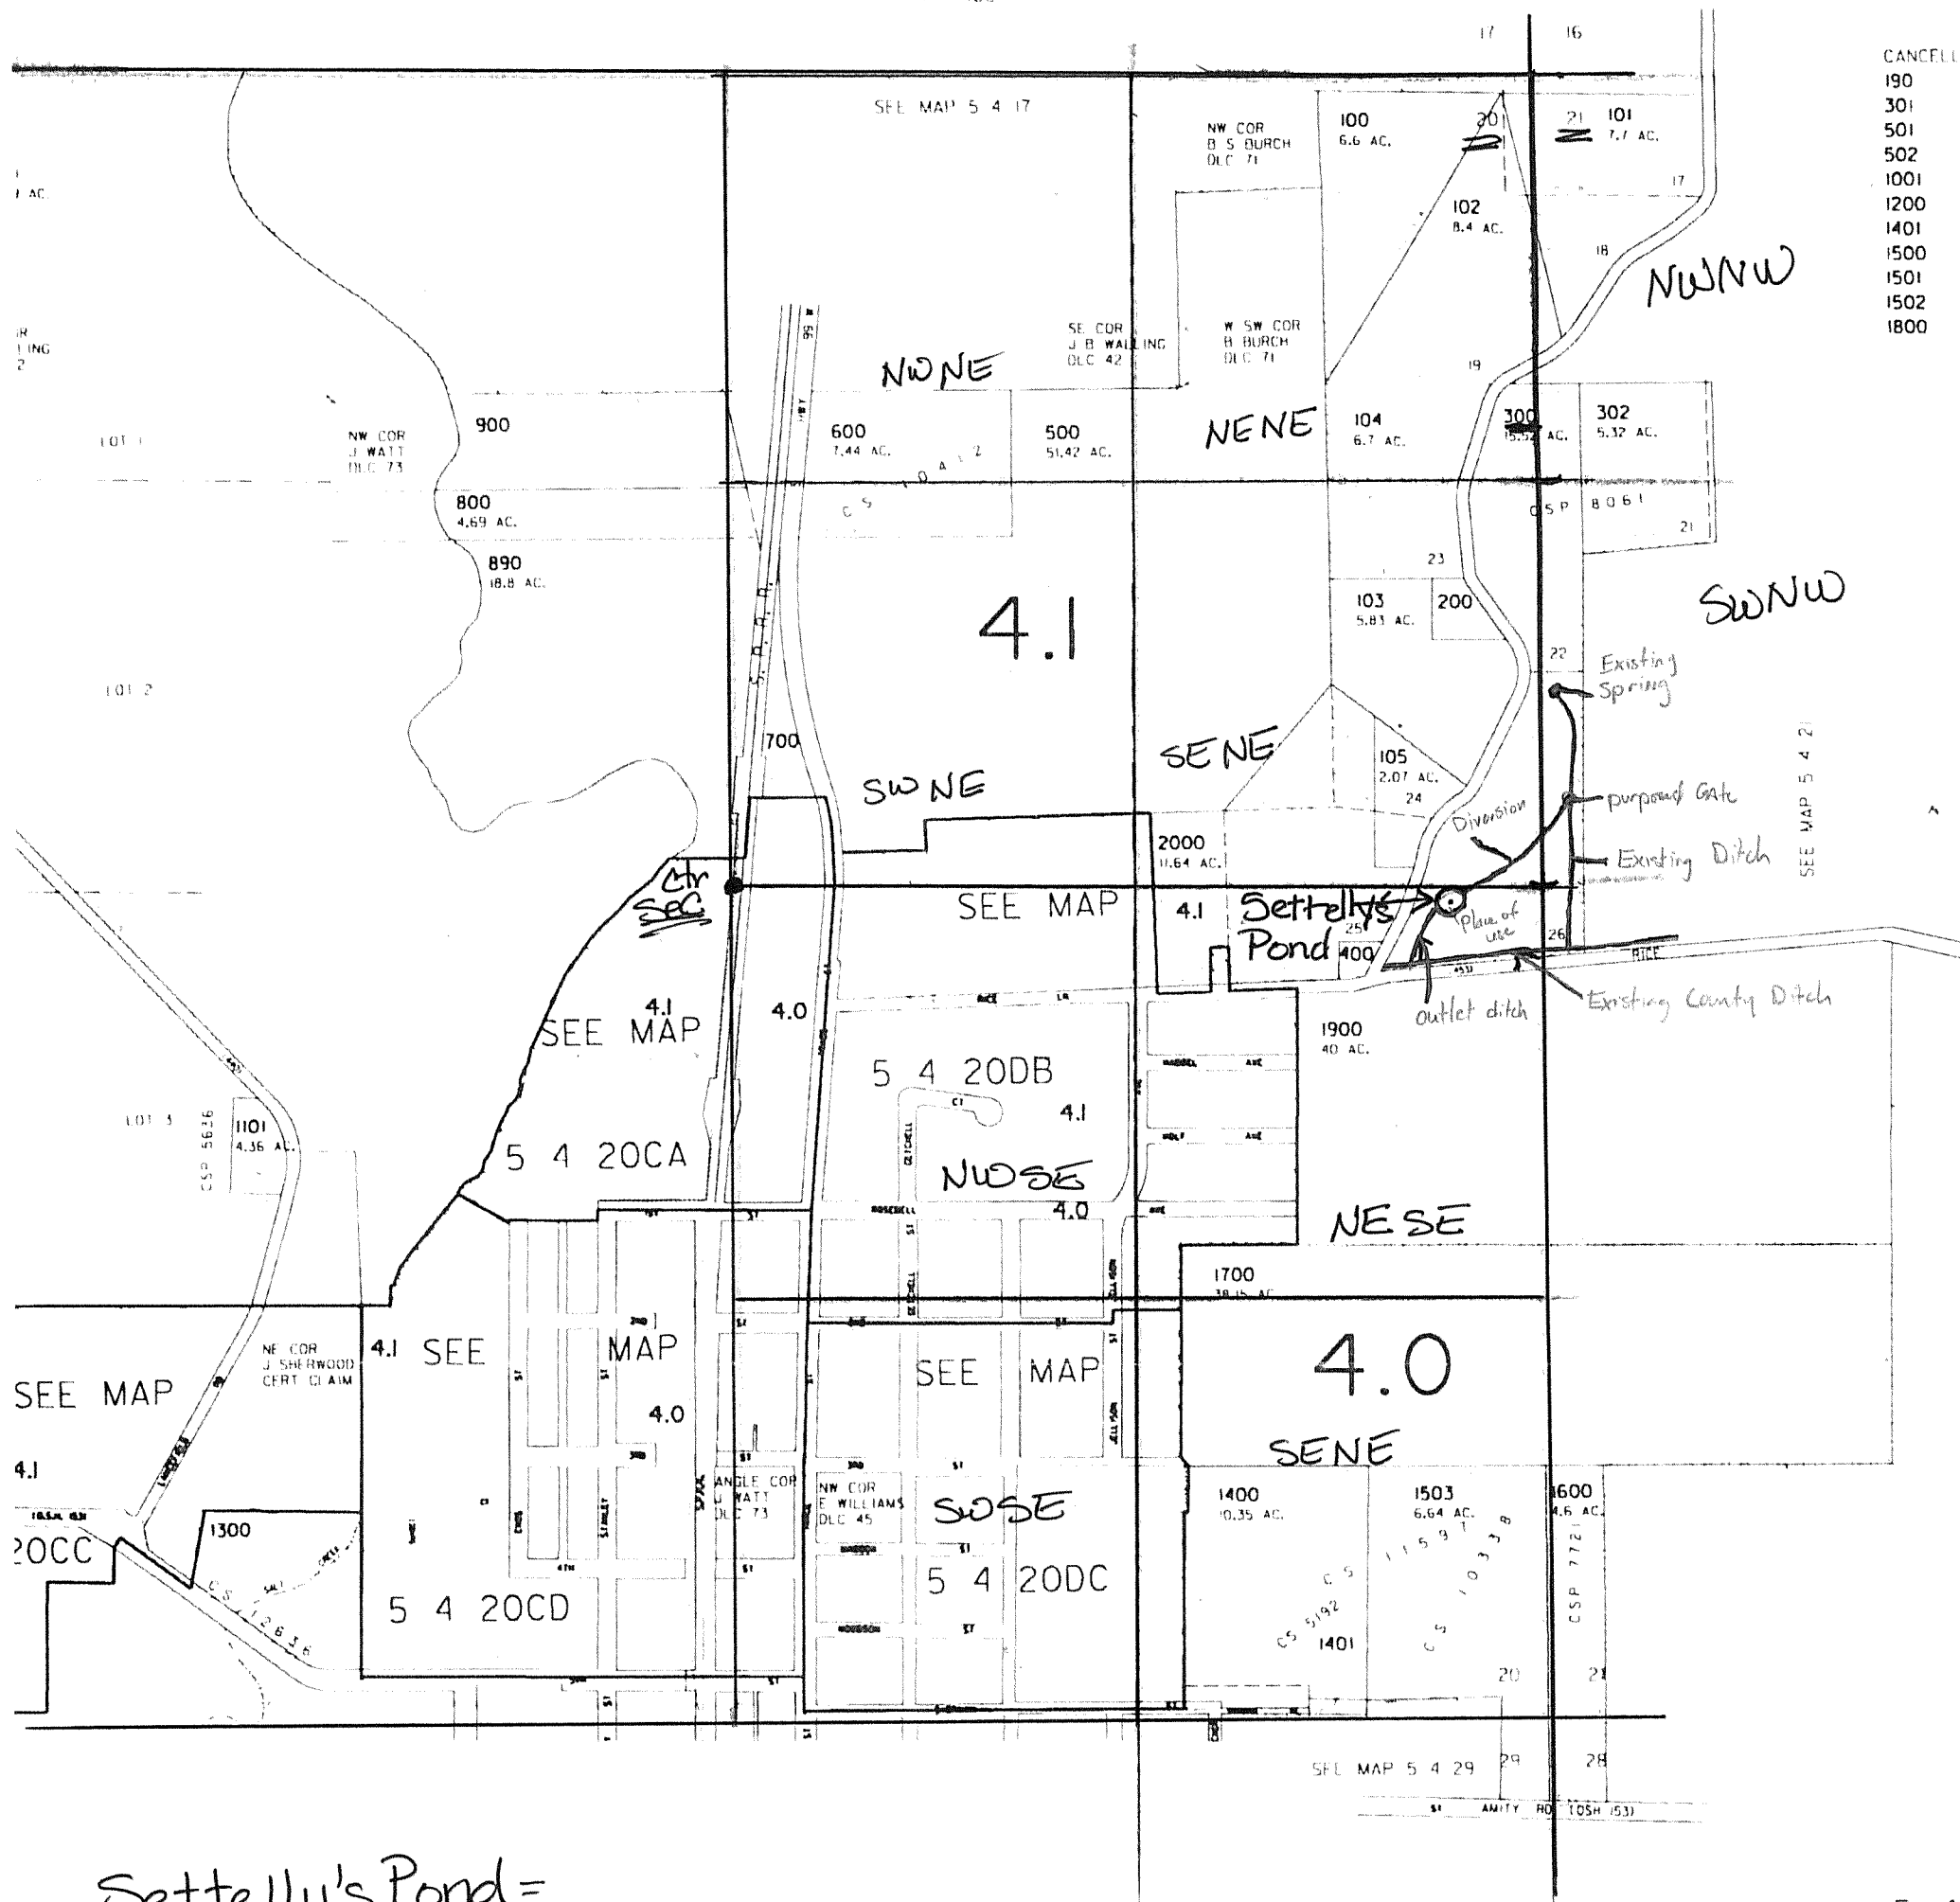

CANCELLED
 190
 301
 501
 502
 1001
 1200
 1401
 1500
 1501
 1502
 1800

Settelly's Pond =

POD = T5S, R4W, Sec 20,
 NESE, Sec 20,
 300' East, 60' S from E 1/4 corner
 west

POD: T5S, R4W, Sec 21,
 SWNW, 60' East, 630 ft N,
 from W 1/4 corner, Sec 21

*Tax Lot 300

Bryce Roberts
 8/13/2013

R287940



RECEIVED

OCT 30 2013

WATER RESOURCES DEPT
SALEM, OREGON

Scale 1" = 600'