


Lakeview Estates Homeowner's Association

1" = 1320'

Tax Lot: 3800



10 South, 4 West, Section 26

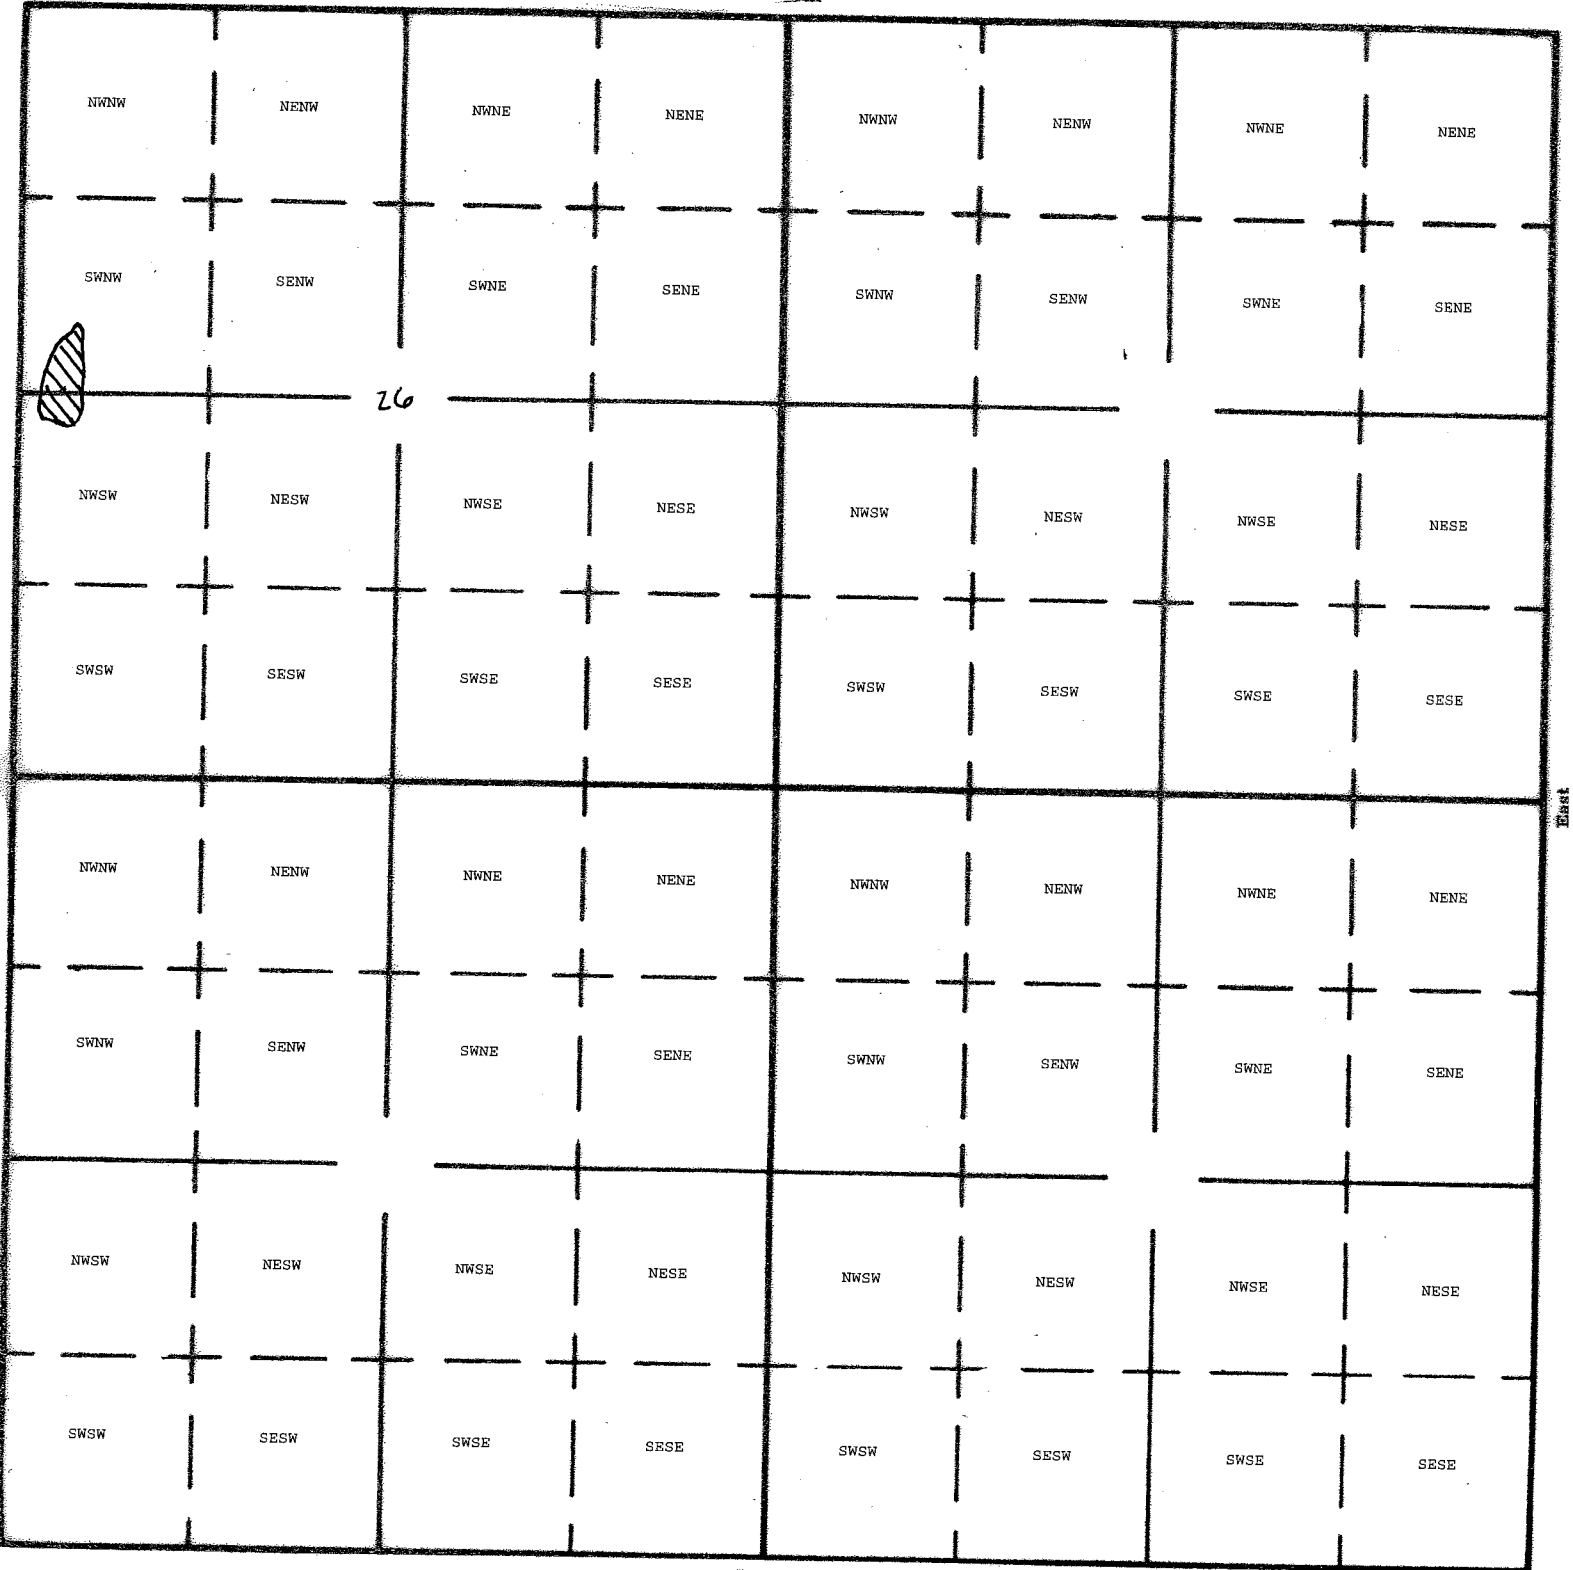

RECEIVED BY OWRD

Dam Location: 230 Feet South and 280 Feet East from W1/4 of Section 26

JUN 11 2014

*RS* R-87981

SALEM, OR