



Scale 1" = 400'

SEE MAP 33 6 32

This map was prepared for assessment purpose only.

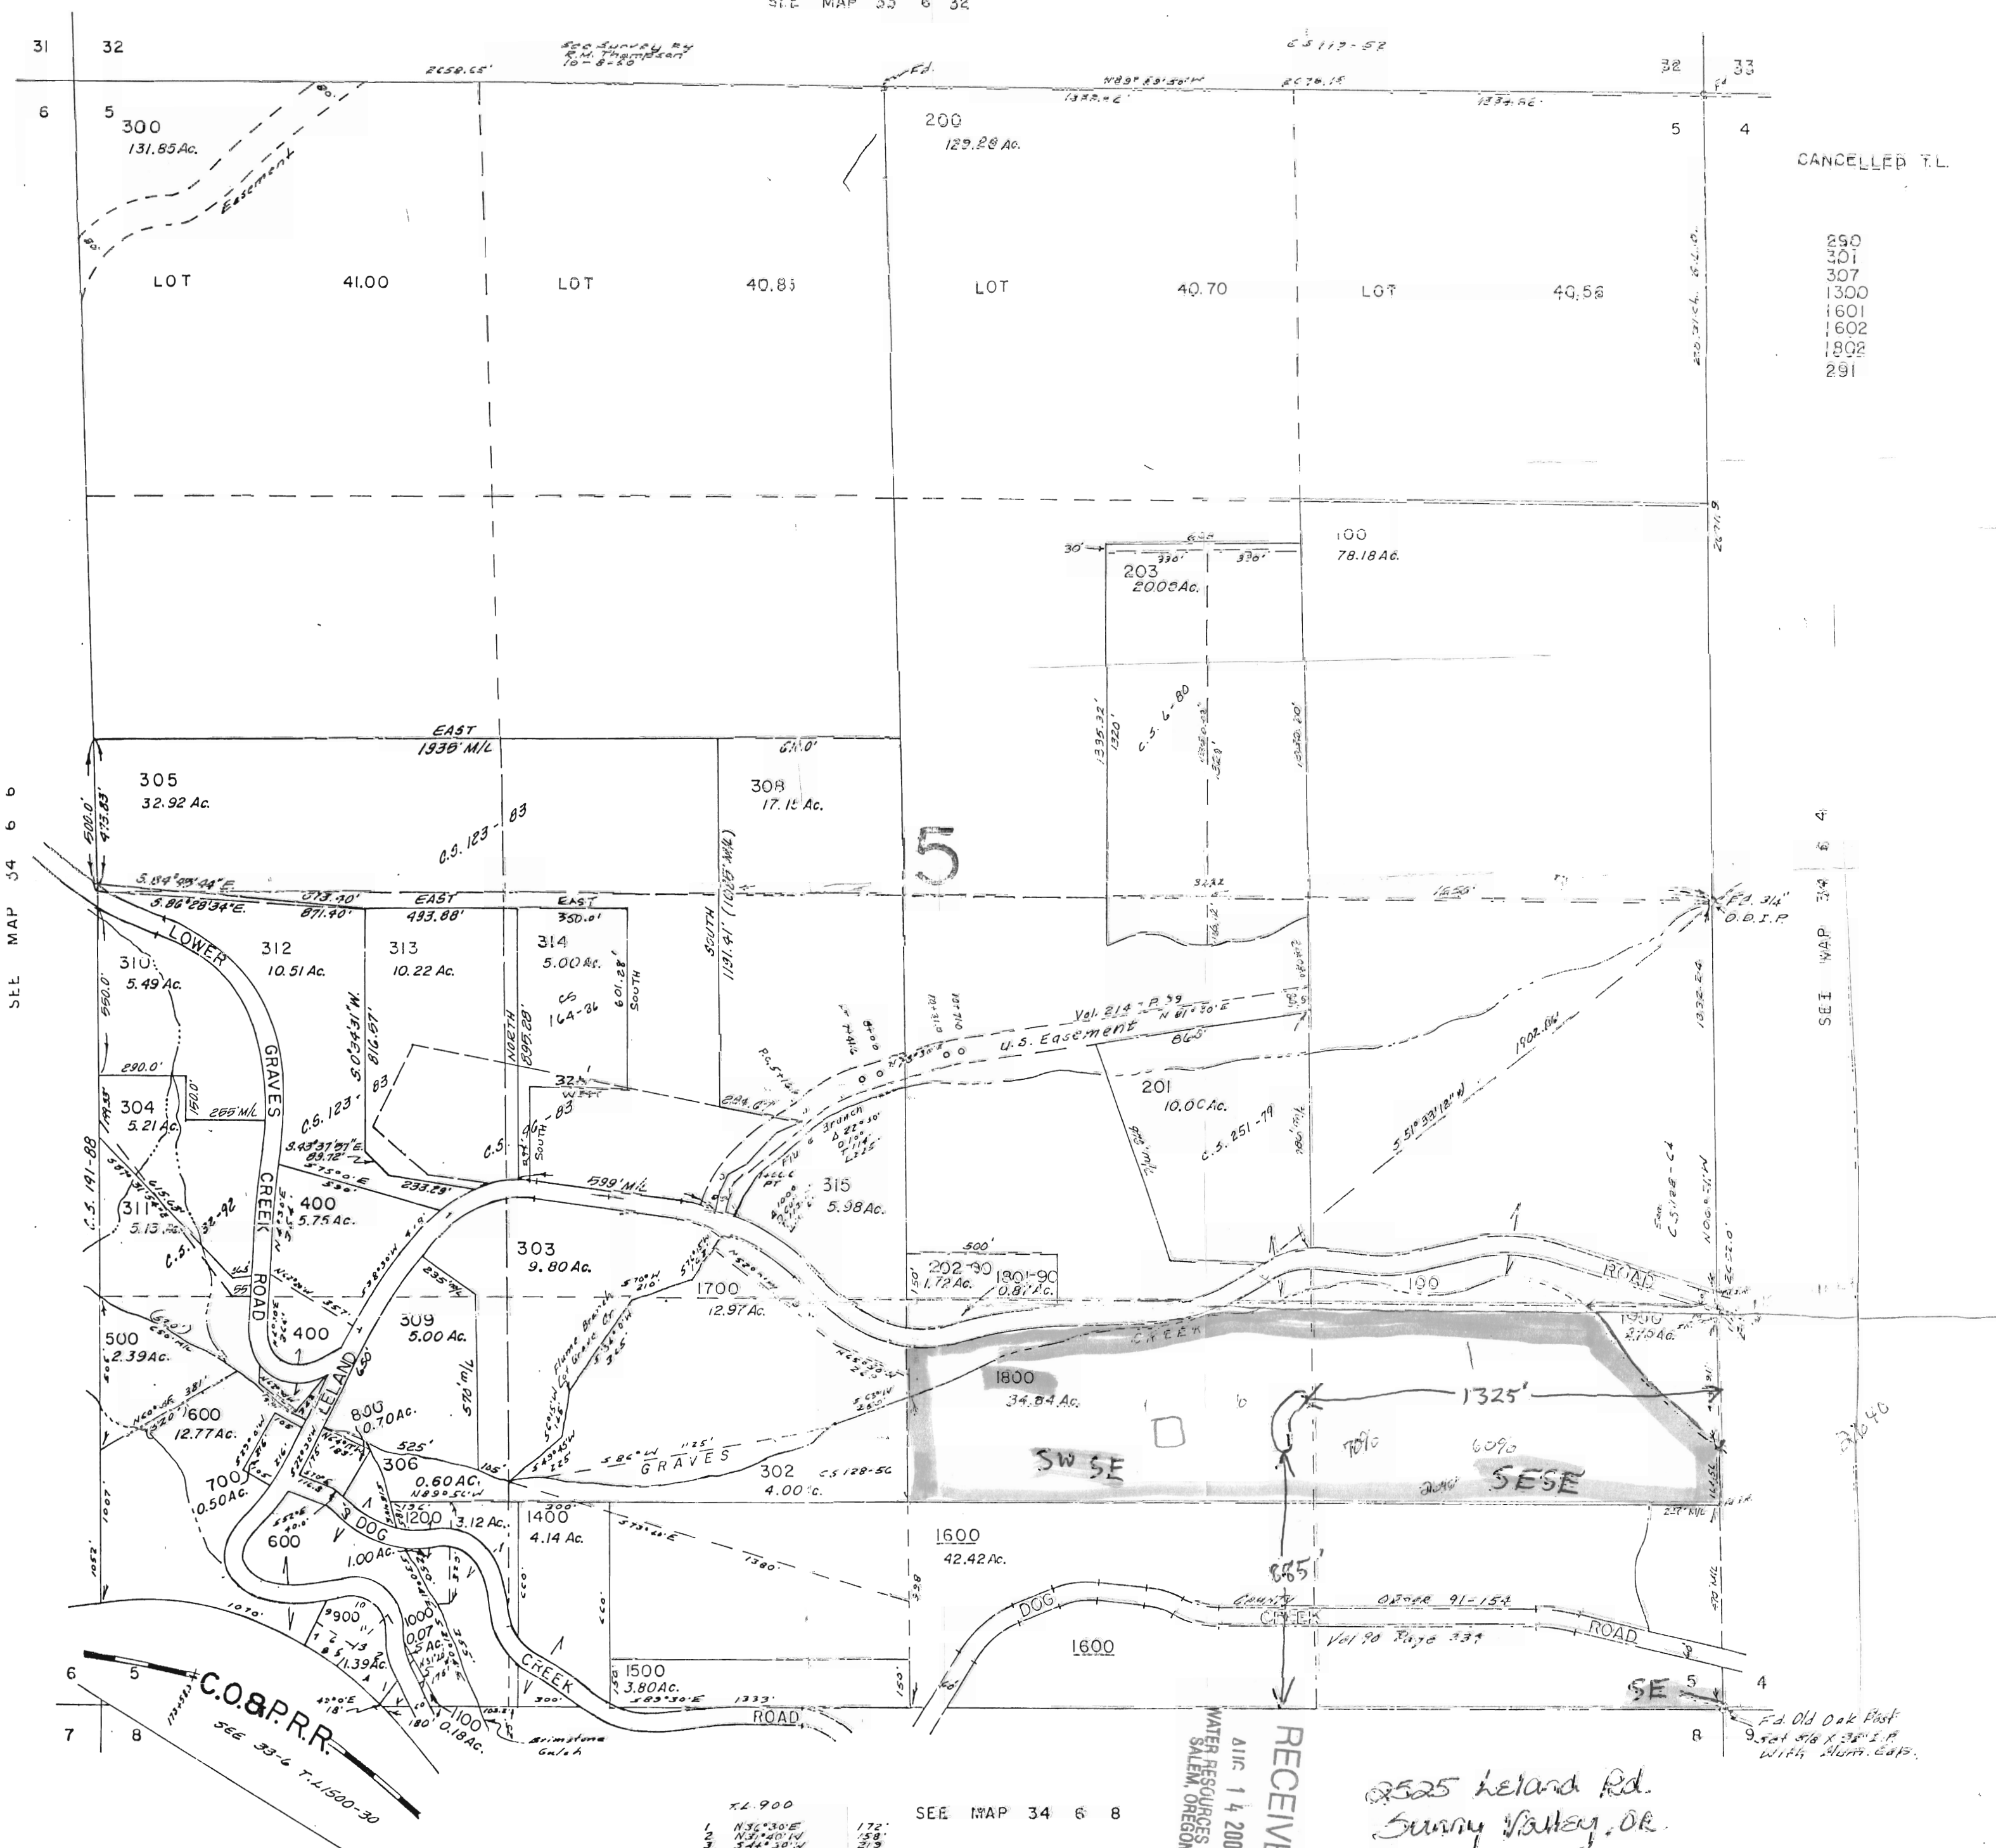

Pond "1" 885' N and 1325' W of SE corner of SESE

SEE MAP 34 6 8

2525 Leland Rd. Sunny Valley, OR.

RECEIVED  
AUG 14 2008  
WATER RESOURCES DEPT  
SALEM, OREGON

