

SEP 29 2014


T 18 S, R 3 W Sec 25

SELEM. OF

TL 113, pond in SE 1/4, NE 1/4

Dem 1125' N & 1290' W from E 1/4 cor Sec 25

Scale 1" = 300'

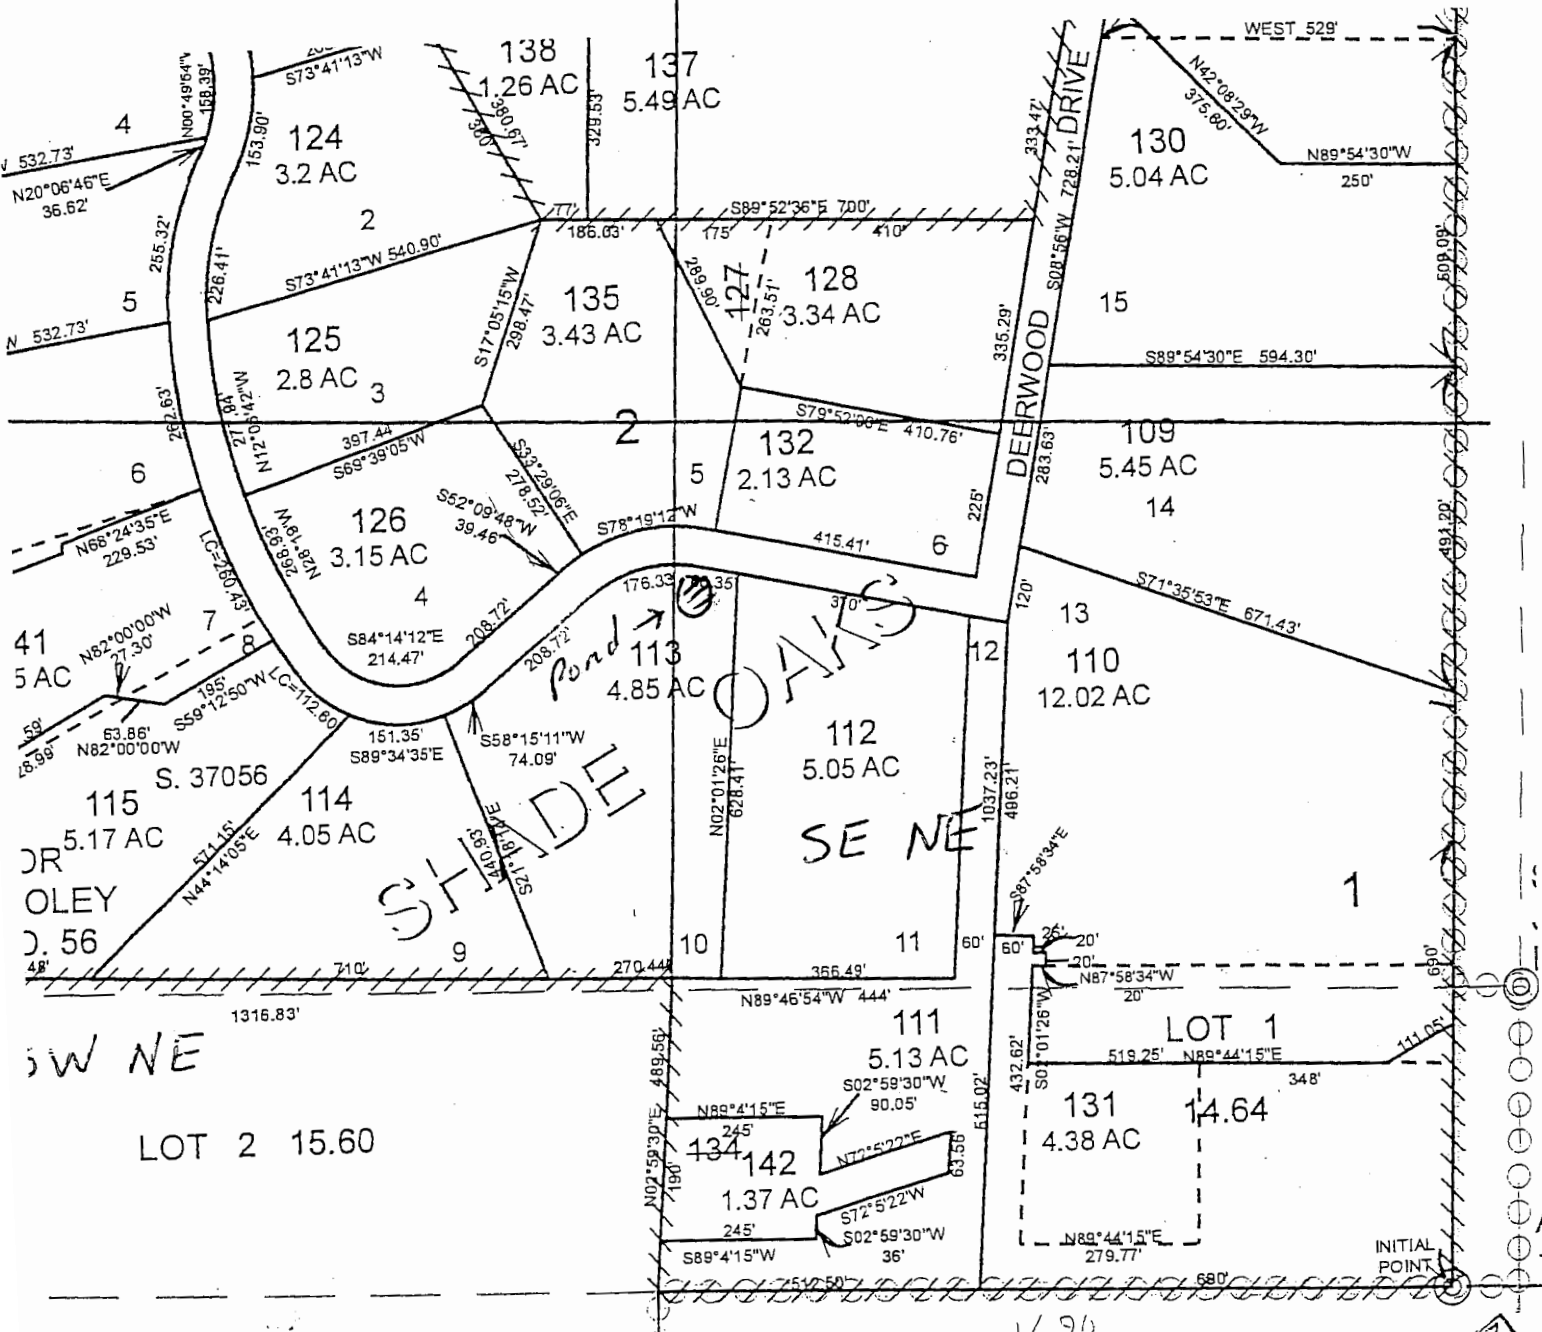

SW NE LOT 2 15.60

R-8805

Approx 1/4 cor

1190

INITIAL POINT