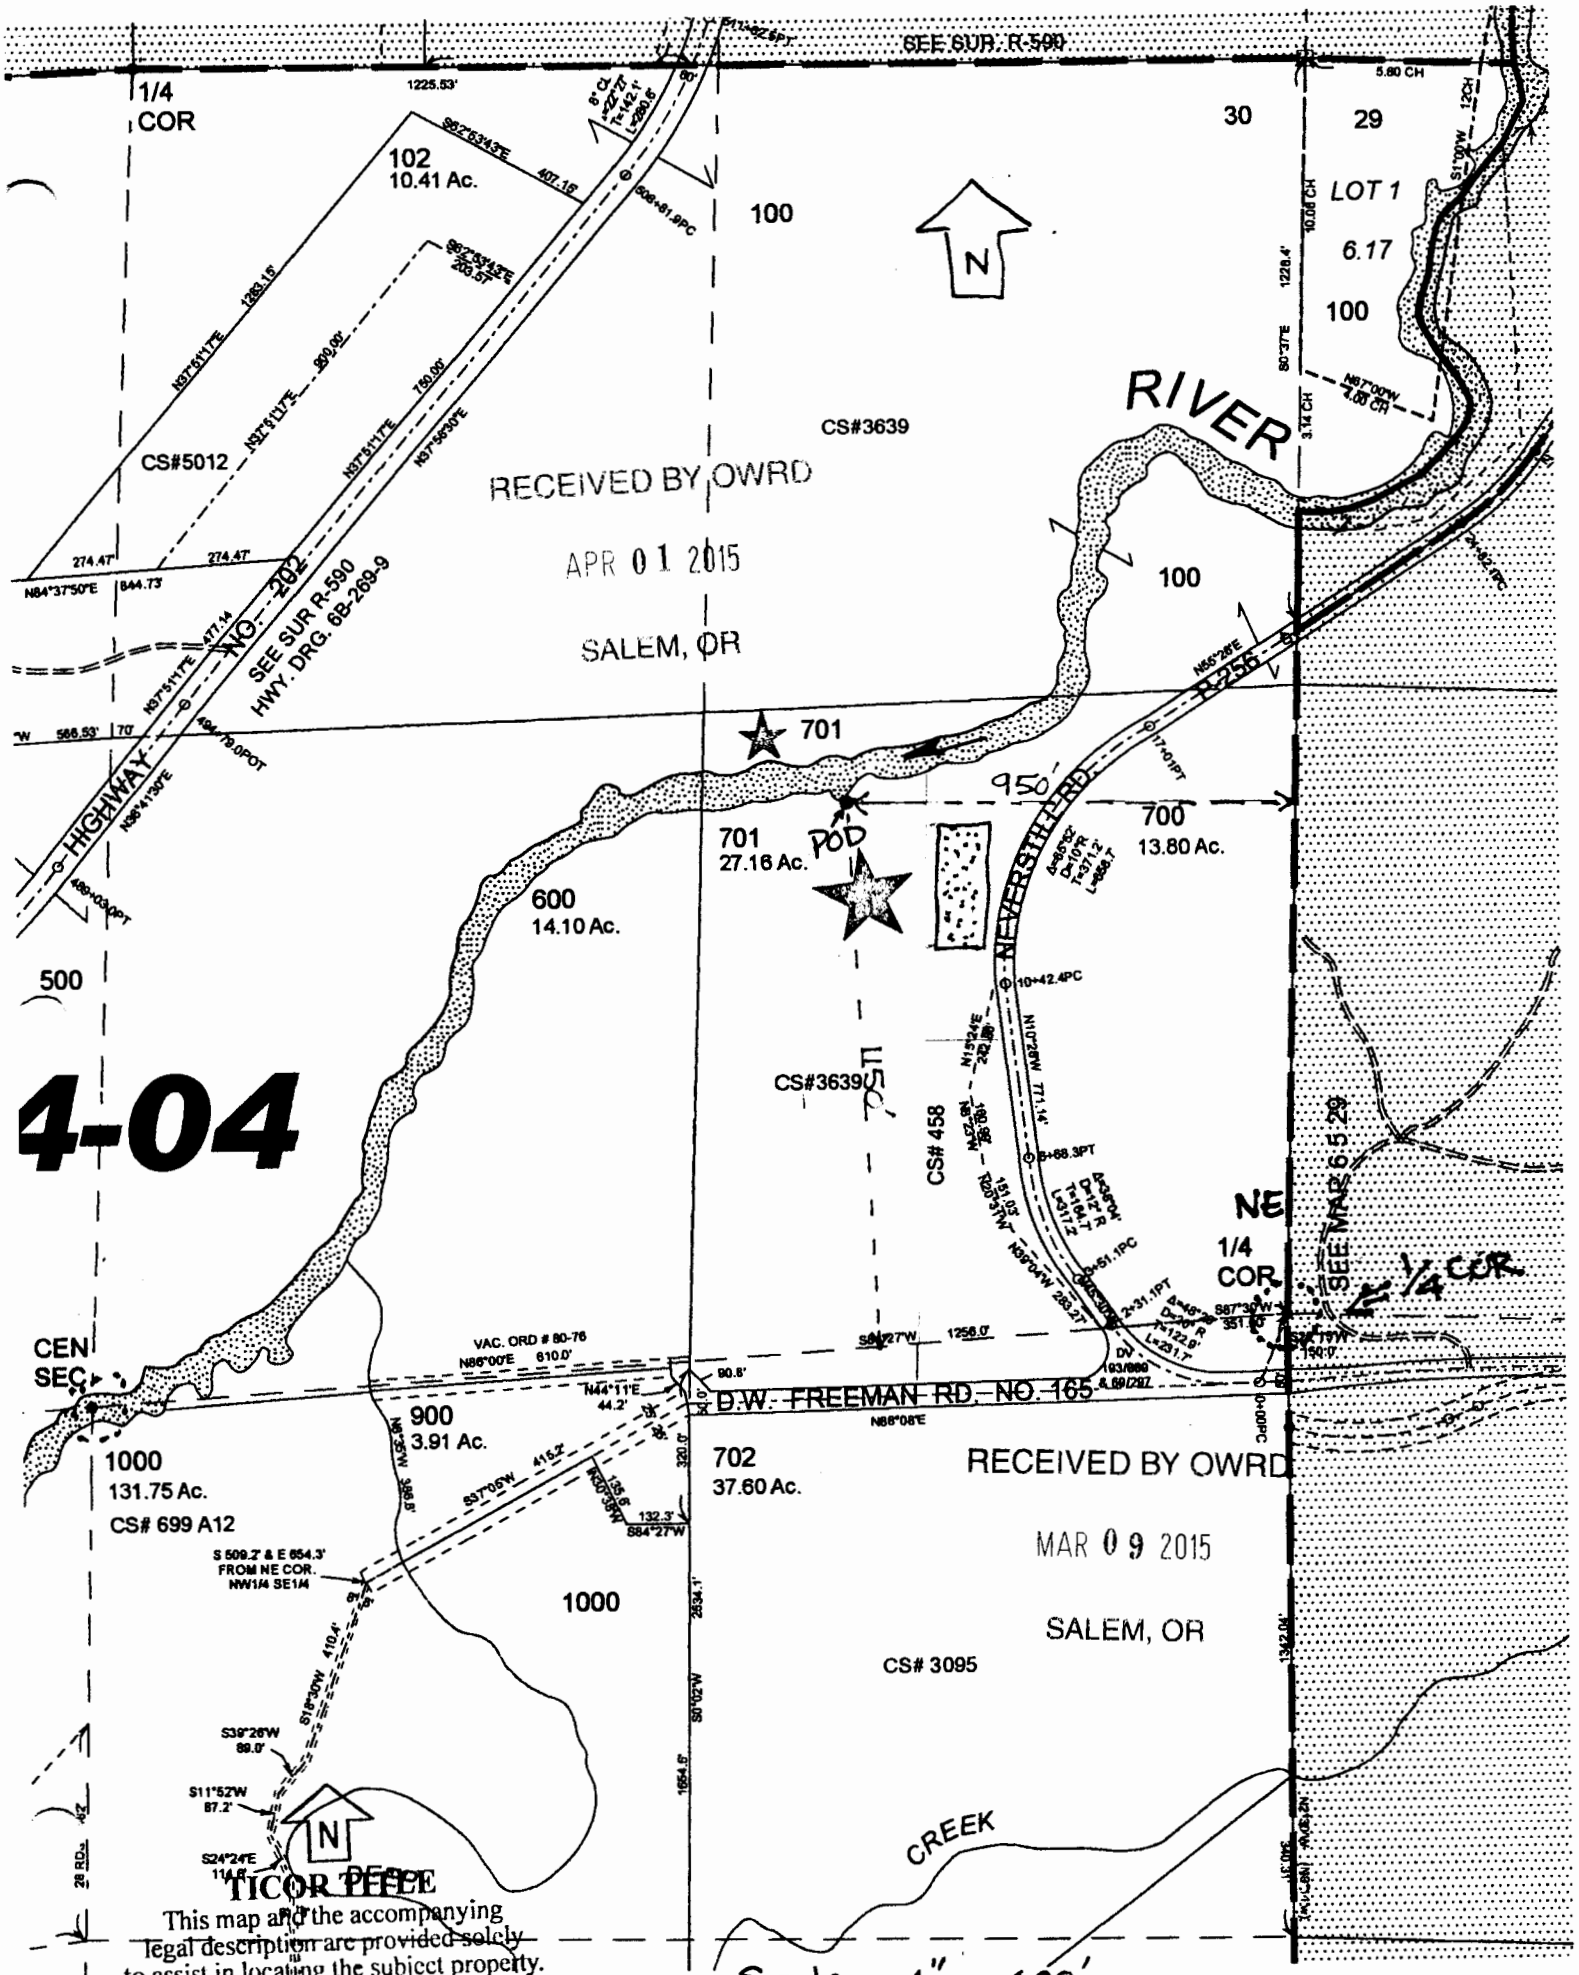

Scale: 1" = 400'

Location: 6N5W30 - SE/NE - Tax lot 701

R-88067